
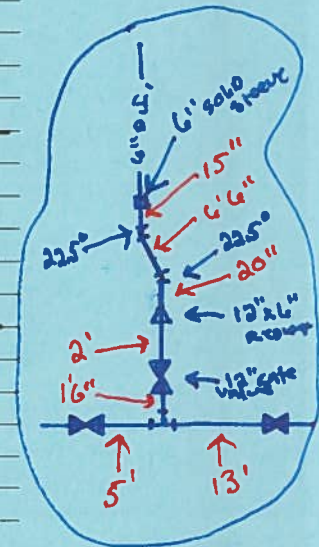


DATE 10/8/2019

TOWN OF LEXINGTON — BOARD OF PUBLIC WORKS
WATER DIVISION

94 Hartwell Ave
Sketch of Service Here

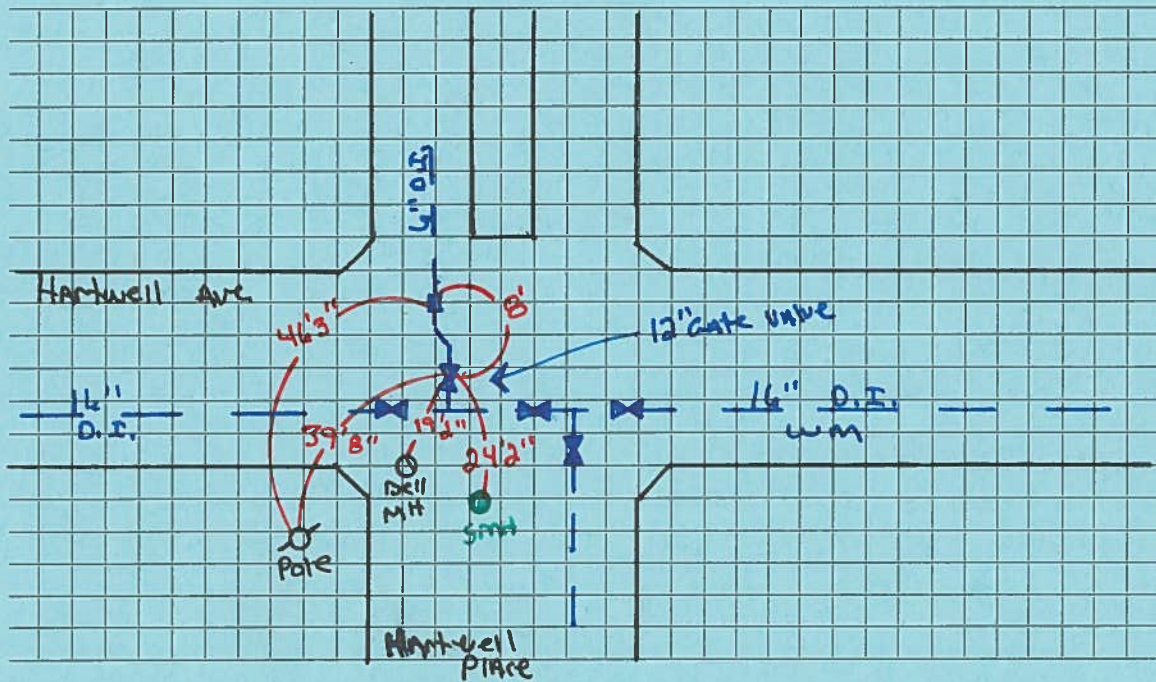

Connection made in ..Hartwell.. AVE Street. Work completed

Remarks:

