

WATER SERVICE RECORD

Name

Service No.

Address

Location LANDFILL HARTWELL AVE

Repair—Renewal—New Service



Date	Material	Amount	Total	Date	Amount
1959	310'	12" CAST I.P.			
	1	12" GATE			
1996	408'	6" DIP			
	1	12x6 REDUCER			
	4	6" 45° BENDS			
	1	6" 90° EL HYD			
	1	6" COUPLING			
	12	6" MEG LUG			
	1	12" MEG LUG			
	3	6" FRICTION CLAMPS			
BLOW OFF	10'	1" COPPER			
	1	1" CORP			
	1	1" CURB			
	1	GATE BOX			

DATE _____

TOWN OF LEXINGTON — BOARD OF PUBLIC WORKS

WATER DIVISION

Sketch of Service Here

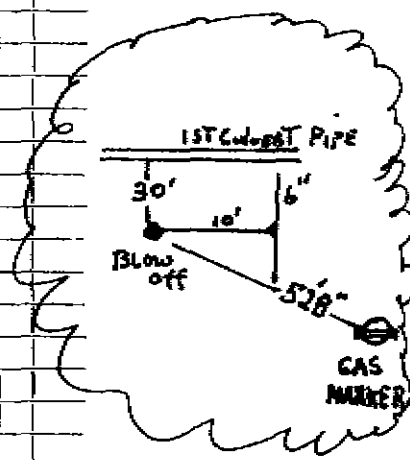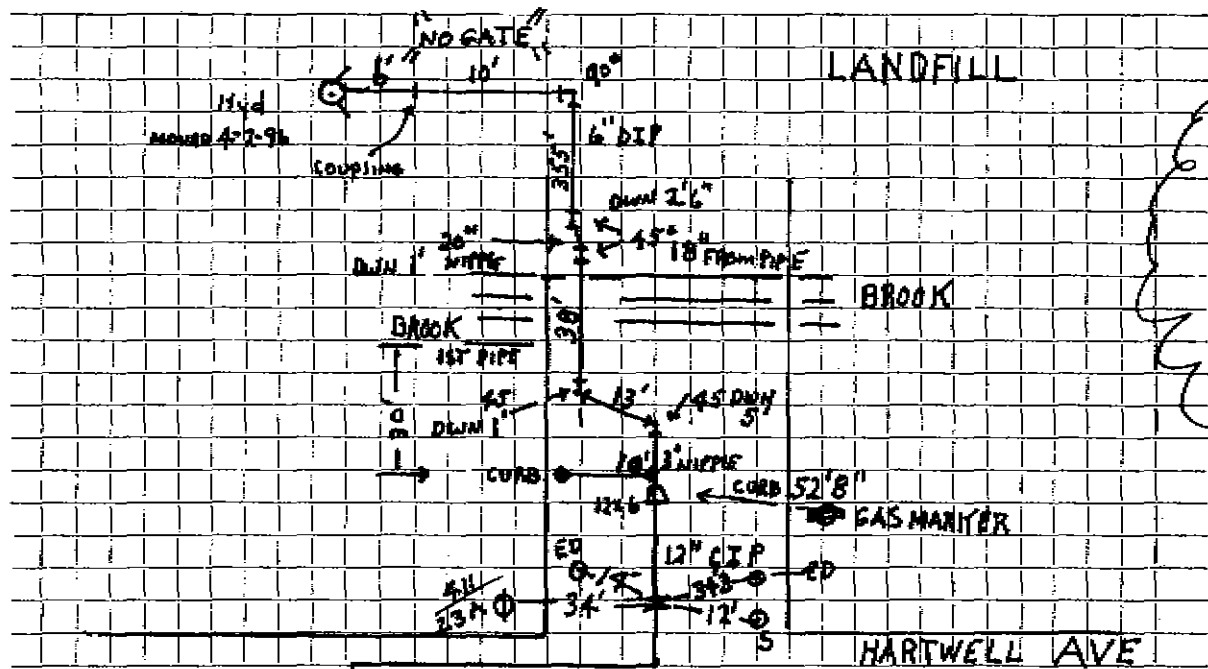

Connection made in HARTWELL AVE 12\"/> Street. Work completed

Remarks: 6\"/>