




Permit #708

DATE 10/12/95.

TOWN OF LEXINGTON — BOARD OF PUBLIC WORKS

WATER DIVISION

Sketch of Service Here

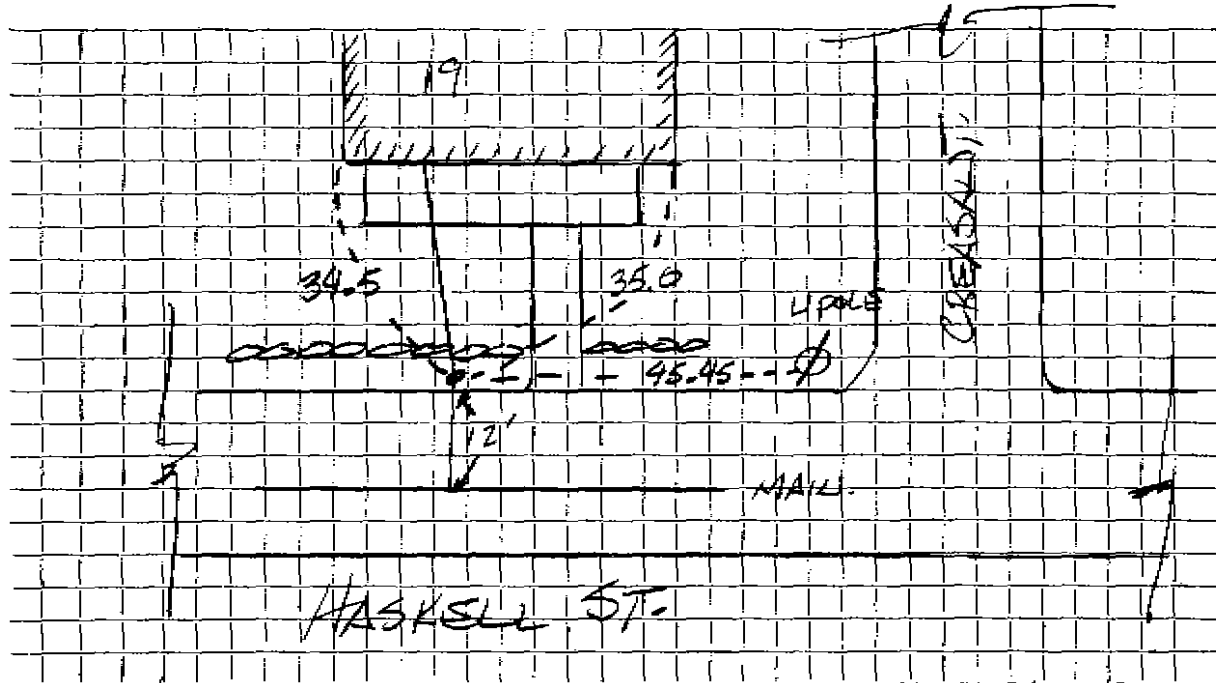

Connection made in 19. HASKELL Street Work completed 10/12/95

Remarks: BRUCE McKEE - CONTRACTOR

T.F.H. - INSPECTOR