

Name

Service No. 1213

Address

23 Haskell St.

# 2211

Location

23 Haskell St.

Kind of Pipe

Size

Size of Main

Repair—Renewal—New Service

Location

Date

Material

Amount

Total

Date

Amount

6-30-04

7'-1" Copper  
1-1" Corp Adaptor  
1-1" Curb Stop

Labor

DATE \_\_\_\_\_

# TOWN OF LEXINGTON—BOARD OF PUBLIC WORKS

## WATER DIVISION

The undersigned applies for a supply of water at No. \_\_\_\_\_ St. and hereby agrees to comply with the rules and regulations as now, or at any future time, established by the Board of Selectmen.

Am't. of Estimate \$ \_\_\_\_\_

Owner


Am't. Paid \$ \_\_\_\_\_

Address

J. E. Howard  
23 Haskell St.

Builder \_\_\_\_\_

Sketch of Service Here

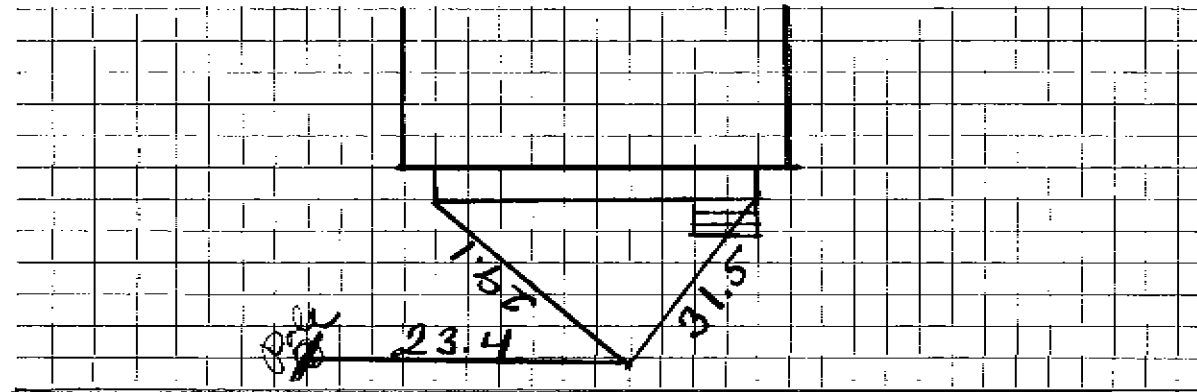

Connection made in \_\_\_\_\_

Haskell Street. St.

Work completed \_\_\_\_\_

19 \_\_\_\_\_

Remarks: