




DATE \_\_\_\_\_

**TOWN OF LEXINGTON -- BOARD OF PUBLIC WORKS**  
**WATER DIVISION**

Sketch of Service Here

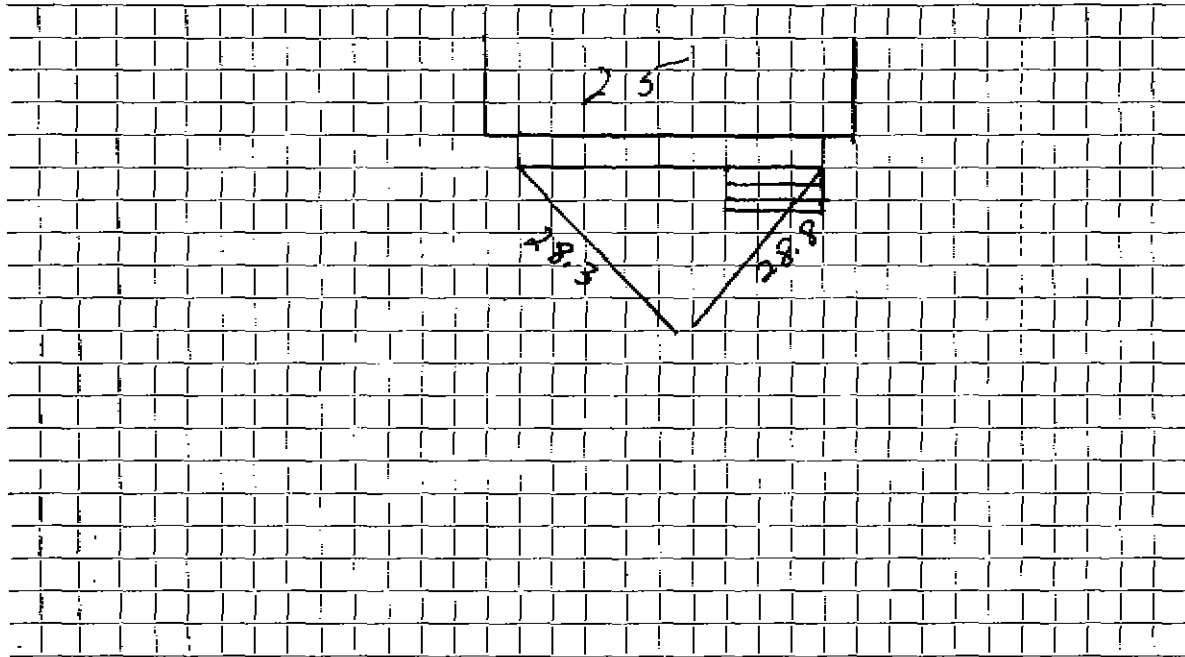

Connection made in ..... Street. Work completed .....

Remarks: .....

.....

.....