

Name

Address

29 Haskell St.

1345

Service No. 1215

Location

29 Haskell St.

Kind of Pipe

Size

Size of Main

Repair—Renewal—New Service

Location

Date

Material

Amount

Total

Date

Amount

Labor

DATE \_\_\_\_\_

# TOWN OF LEXINGTON—BOARD OF PUBLIC WORKS

## WATER DIVISION

The undersigned applies for a supply of water at No. \_\_\_\_\_ St. and hereby agrees to comply with the rules and regulations as now, or at any future time, established by the Board of Selectmen.

Am't. of Estimate \$ \_\_\_\_\_

Owner

J. S. Holderson


Am't. Paid \$ \_\_\_\_\_

Address

29 Haswell St.

Builder \_\_\_\_\_

Sketch of Service Here

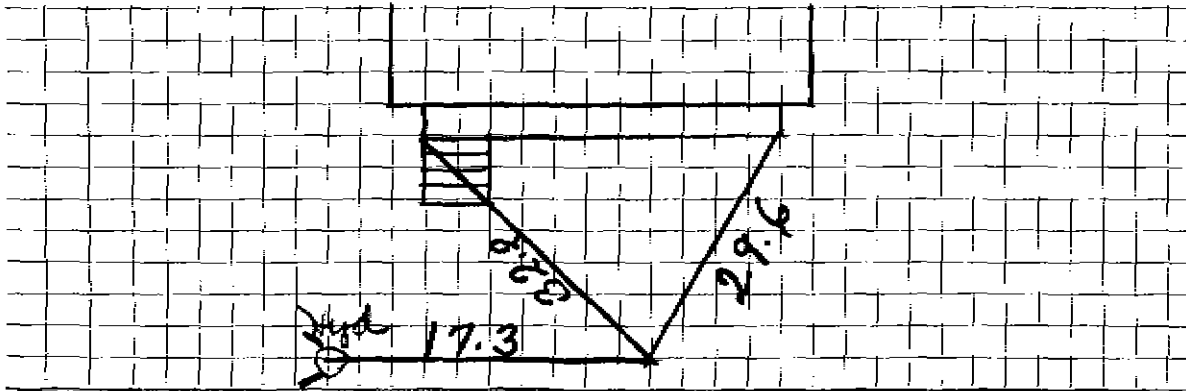

Connection made in Haswell Street. St. Work completed \_\_\_\_\_ 19

Remarks: