

# WATER SERVICE RECORD

Name

Service No.

Address

8 Haskell St

Location

was - 5 Lowell St

Pg 28-10T104

Repair—Renewal—New Service


RW-448A

Date	Material	Amount	Total	Date	Amount
5-1996	1" Copper casing to house				
	1" Corp				
	1" curb stop				
	Box				

TOWN OF LEXINGTON — BOARD OF PUBLIC WORKS

WATER DIVISION

Sketch of Service Here

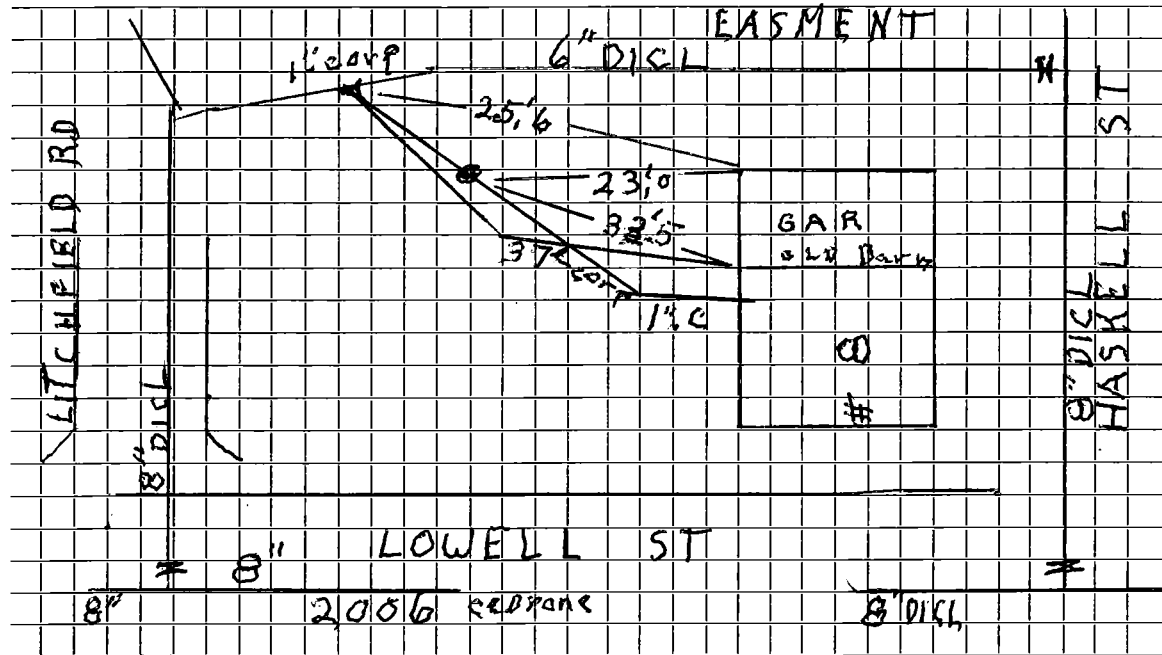

IN. EASEMENT  
 Connection made in Haskell St. No. 8 Street. Work completed 1.9.96  
 Remarks: was 51 Lowell St. house moved to Lowell & Haskell (now # 8 Haskell)  
2013 - installing 8" W. on Haskell St.