


DATE 10-4-01

TOWN OF LEXINGTON — BOARD OF PUBLIC WORKS
WATER DIVISION

Sketch of Service Here

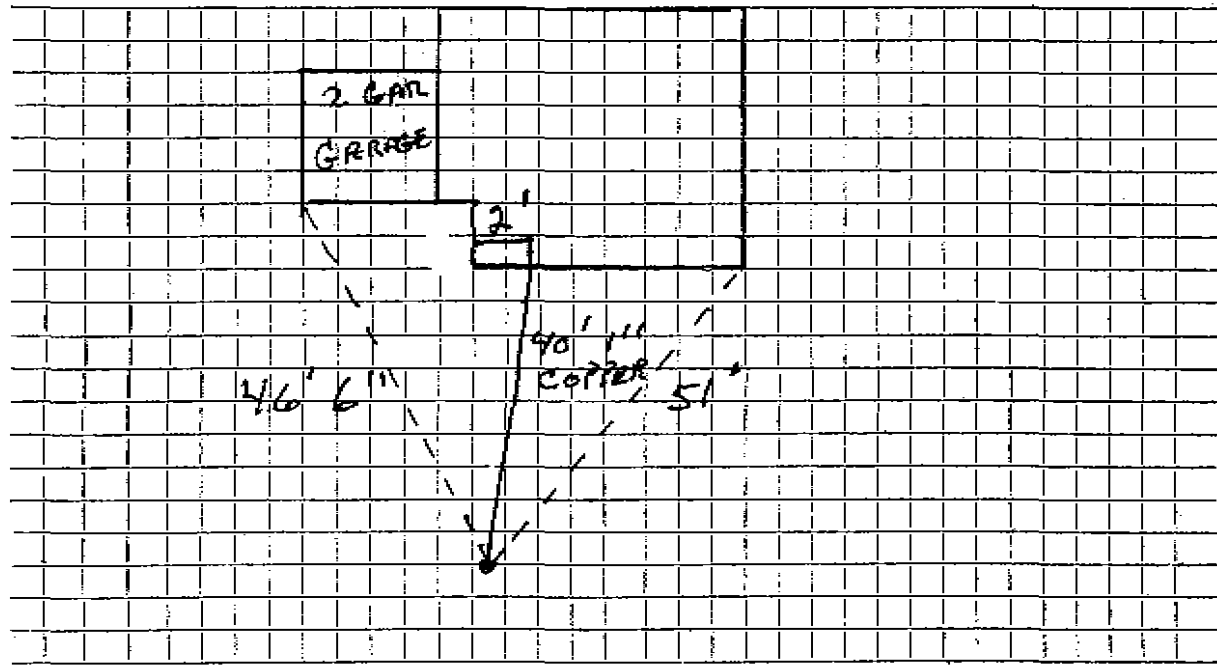

Connection made in HASKELL Street. Work completed

Remarks: INSTALLED BY J. McLAUGHLIN