




DATE \_\_\_\_\_

TOWN OF LEXINGTON — BOARD OF PUBLIC WORKS  
WATER DIVISION

Sketch of Service Here

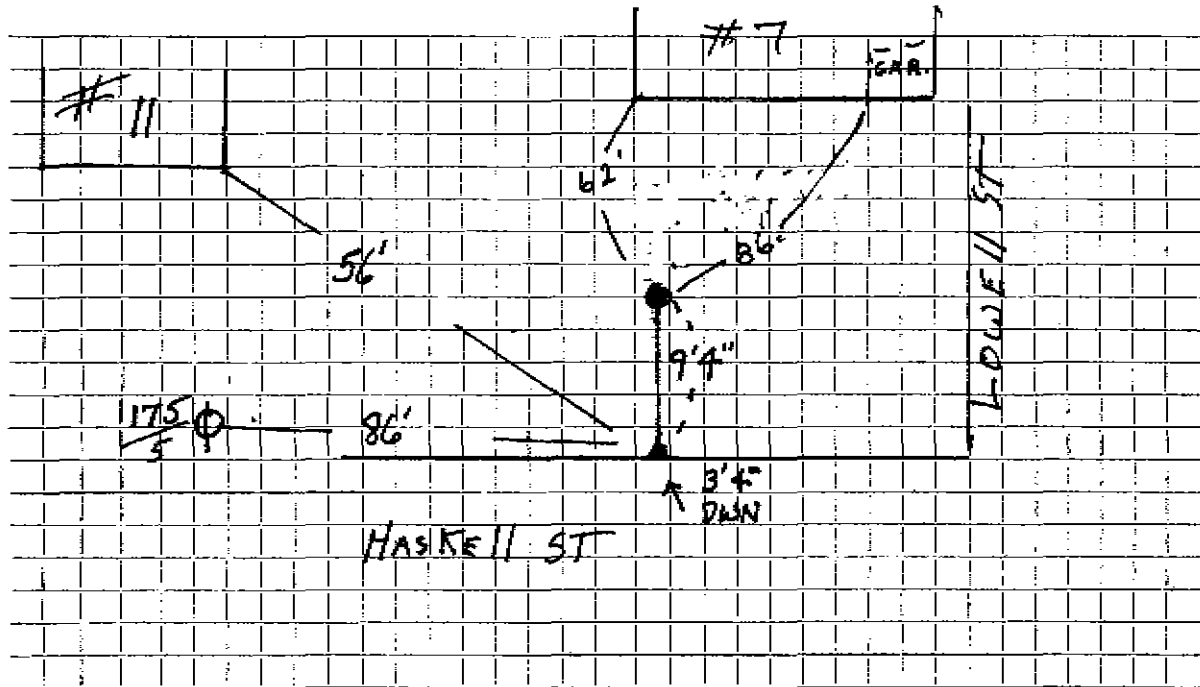

Connection made in HASKELL ST Street. Work completed 8-4-93

Remarks: U.S.R.D. EXISTING 1" COP. GOOSENECK IS 2'9" DOWN W/INSULATION