

WATER SERVICE RECORD

Name Harvey W. Newgent

Service No. 305

Address 21 Hastings Road

Location

~~Renewal~~ ~~NEW SERVICE~~

Comm. 12-3-56


Date	Material	Amount	Total	Date	Amount
9/29/56	Labor	32.25		9-27-56	Deposit \$150.00
	10% O.H.	3.23	35.48	12-3-56	Refund 31.50
	75' 1" Copper tubing @.4850		36.38		NON CHARGE 118.50
	1' 1" C x 3/4" I.W.H. Stop & Waste	4.96			Labor 4.15
	1 1" Union (3 part)	2.27		10' 1" Copper tubing @.4850	4.85
	1/2 hr. Littlefield @9.50	38.00		1 1" C Corp Cock	4.64
	2 hr. trucking @.75	1.50		1 1" C Curb Cock	5.94
		118.50		1 Box and Rod	4.62
				1 3/4" Straight tail piece	.50
				1 3/4" Offset tail piece	.50
				2/3 hr. Littlefield @ 9.50	6.34
				1 hr. Trucking @.75	.75
				8 x 3 Patching	8.00
					10.29

DATE _____

TOWN OF LEXINGTON — BOARD OF PUBLIC WORKS

WATER DIVISION

Sketch of Service Here

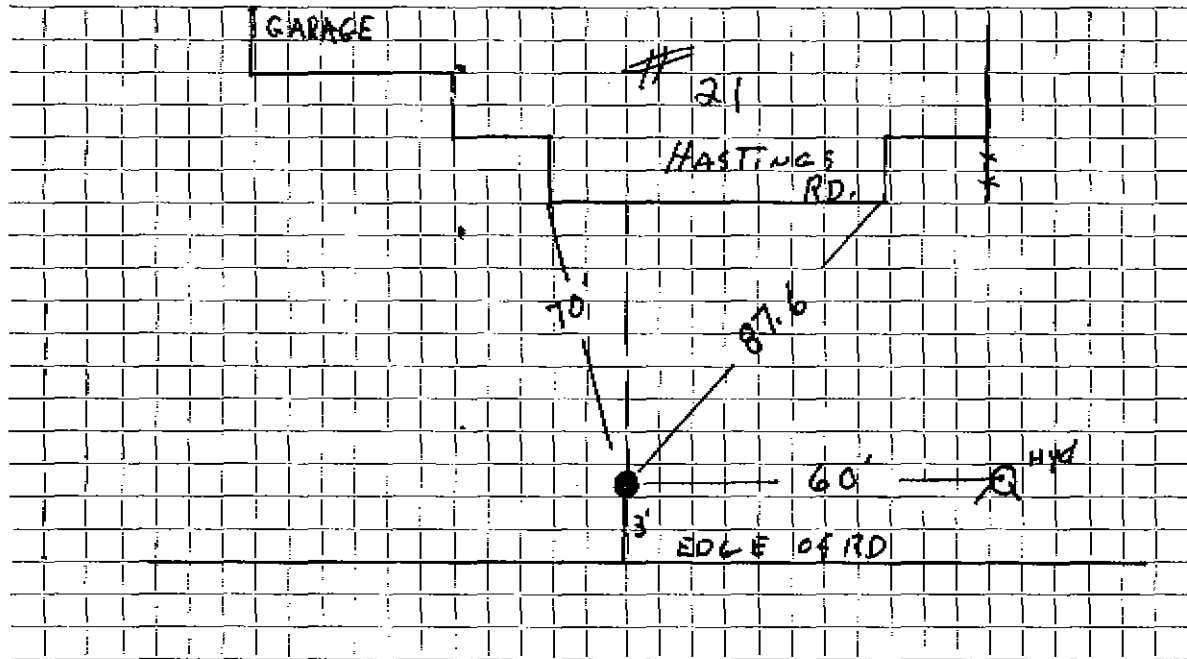

Connection made in _____ Street. Work completed _____

Remarks: _____
