

WATER SERVICE RECORD

389

Name Daniel Gorman

Service No. 287

Address 11 Hastings Road, Lexington

Location Mail to:
45 Reed Street, Lexington

Repair - Renewal - New Service

Com. 11-21-55


Date	Material	Amount	Total	Date	Amount
8/30/55	Labor	1 85		8-26-55	Deposited 25 00
	10% Overhead	19	2 04	11-21-55	Refunded (2 85)
	40' - 3/4" Copper tubing @ .384	15 36			Non Charge 22 15
	1-3/4" Cx 1/2" I.W.P. stop & waste	4 00	8/30/55	Labor	1 85
	1 hr. trucking @ .75		75	5' 3/4" Copper tubing @ .384	1 92
			22 15	1-3/4" C. Corp Cock	4 33
				1-3/4" Cx 3/4" C. Cock	4 67
				1 Box & Rd	3 90
				1-1/2" offset tail piece	50
				1-1/2" straight tail piece	50
				1 hr. trucking @ .75	75
					18 42

DATE _____

TOWN OF LEXINGTON — BOARD OF PUBLIC WORKS

WATER DIVISION

Sketch of Service Here

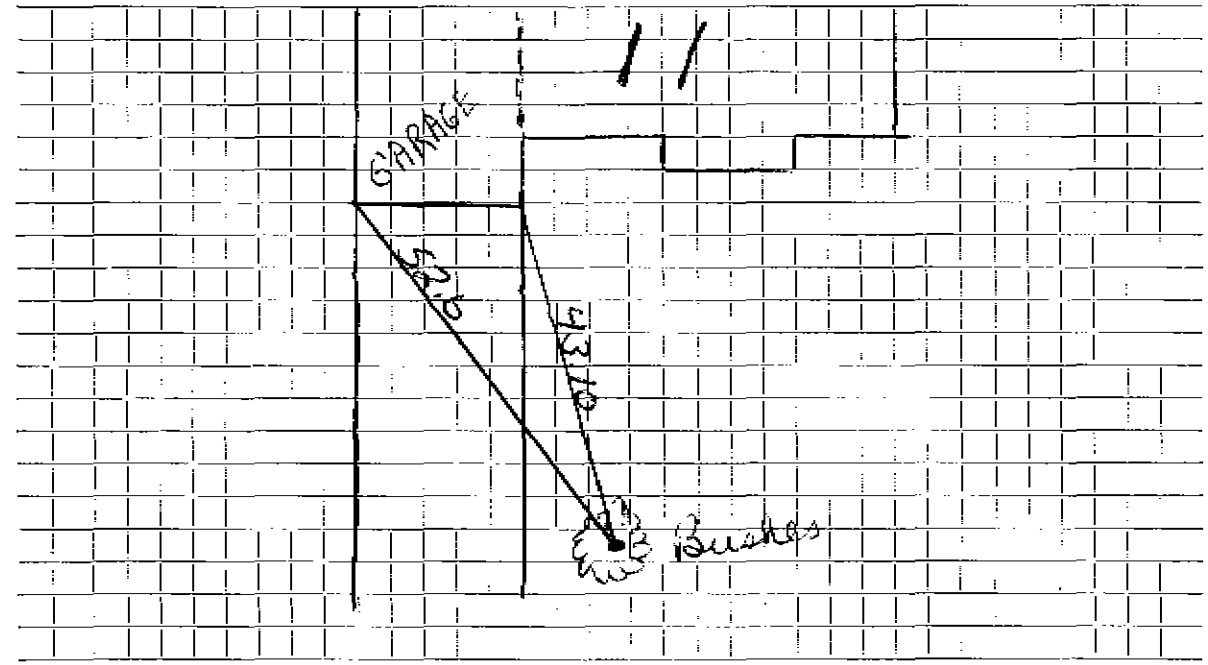

Connection made in Street. Work completed

Remarks: *Bush is gone*

.....
.....