

WATER SERVICE RECORD

Name

Service No.

Address

14 Hastings Road

Location

~~Repair - Renewal~~ New Service

Service into curb only


Date	Material	Amount	Total	Date	Amount
11/15/56					
	73' 3/4 COPPER				
	1 3/4 UNIONS (3PART)				
	1 3/4 X 1/2 S+LW				
				9/16/55	1 60
				Non Charge	
				Labor	1 60
				27' - 3/4" Copper tubing @.56	15 12
				1 - 3/4" C. Corp Cock	4 33
				1 - 3/4" C. Curb Cock	4 67
				1 Box & Rod	3 90
				1 hr. trucking @.75	75
					30 37

DATE _____

TOWN OF LEXINGTON — BOARD OF PUBLIC WORKS

WATER DIVISION

Sketch of Service Here

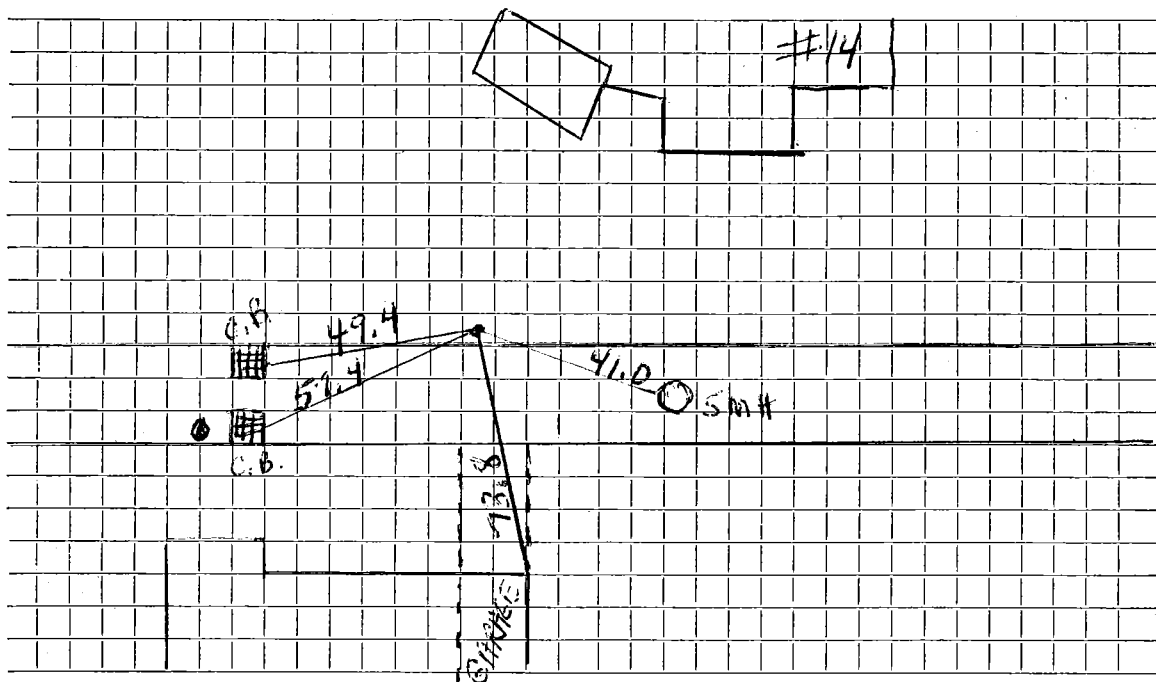

Connection made in Street. Work completed

Remarks:
.....
.....