

WATER SERVICE RECORD

Service No. 88

Name Harvey W. Newgent

Address 15 Hastings Road

Location

~~Repair~~ ~~Renewal~~ New Service

Service into curb only


Comm 9-24-56

Date	Material	Amount	Total	Date	Amount
4/13/56					
	96' 3/4 COPPER				
	1 3/4 UNION (3 PART)				
	1 3/4 x 1/2 S & W				
				Non charge	
				9/16/55 Labor	1 60
				12'-3/4" Copper tubing @.56	6 72
				1-3/4" C. Corp Cock	4 67
				1-3/4" C. Curb Cock	4 33
				1 Box & Rod	3 90
				1 hr. trucking @.75	75
					<u>21.97</u>

DATE _____

TOWN OF LEXINGTON — BOARD OF PUBLIC WORKS
WATER DIVISION

Sketch of Service Here

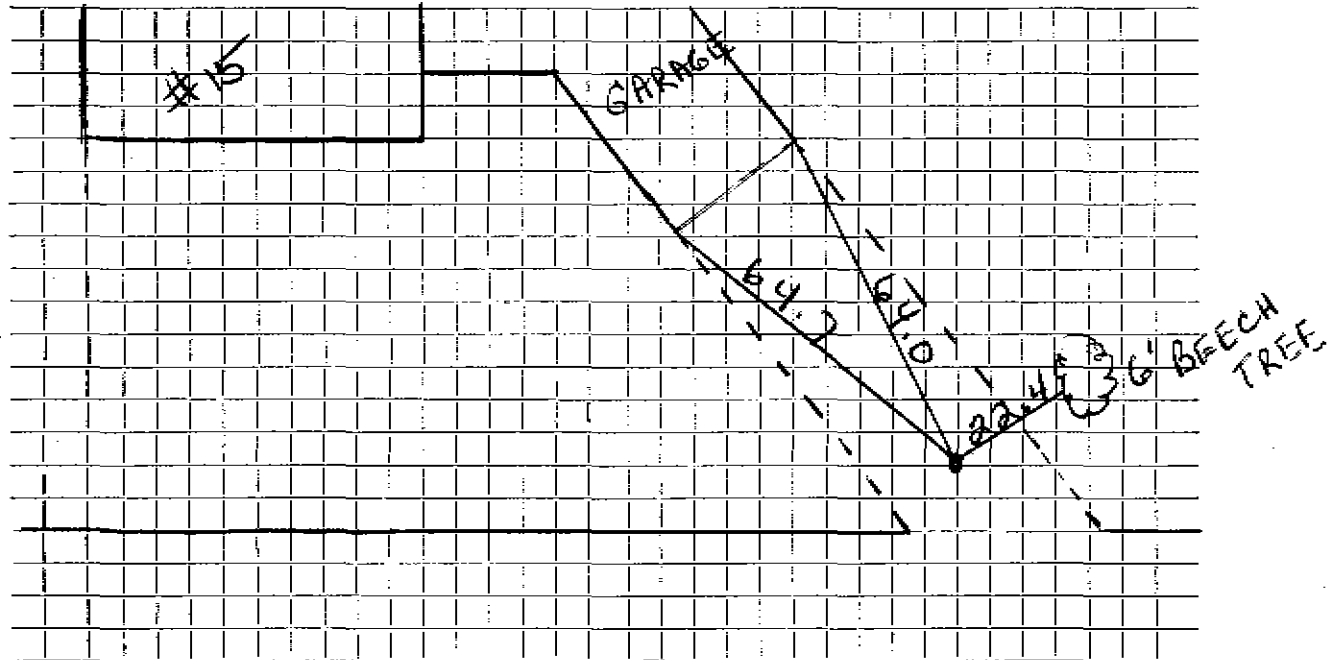

Connection made in Street. Work completed

Remarks:
.....
.....