

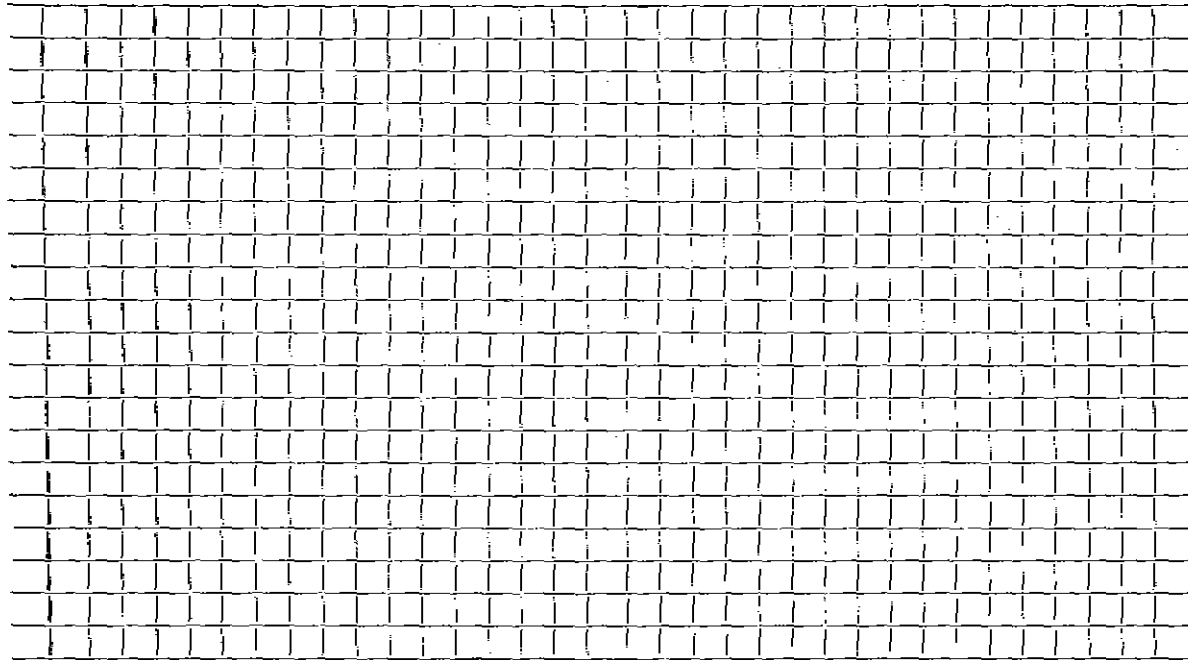


DATE \_\_\_\_\_

**TOWN OF LEXINGTON — BOARD OF PUBLIC WORKS**

**WATER DIVISION**

Sketch of Service Here

A large rectangular area filled with a grid of small squares, intended for drawing a sketch of service details.

Connection made in ..... Street. Work completed .....

Remarks: .....

.....

.....