


DATE _____

TOWN OF LEXINGTON — BOARD OF PUBLIC WORKS
WATER DIVISION

Sketch of Service Here

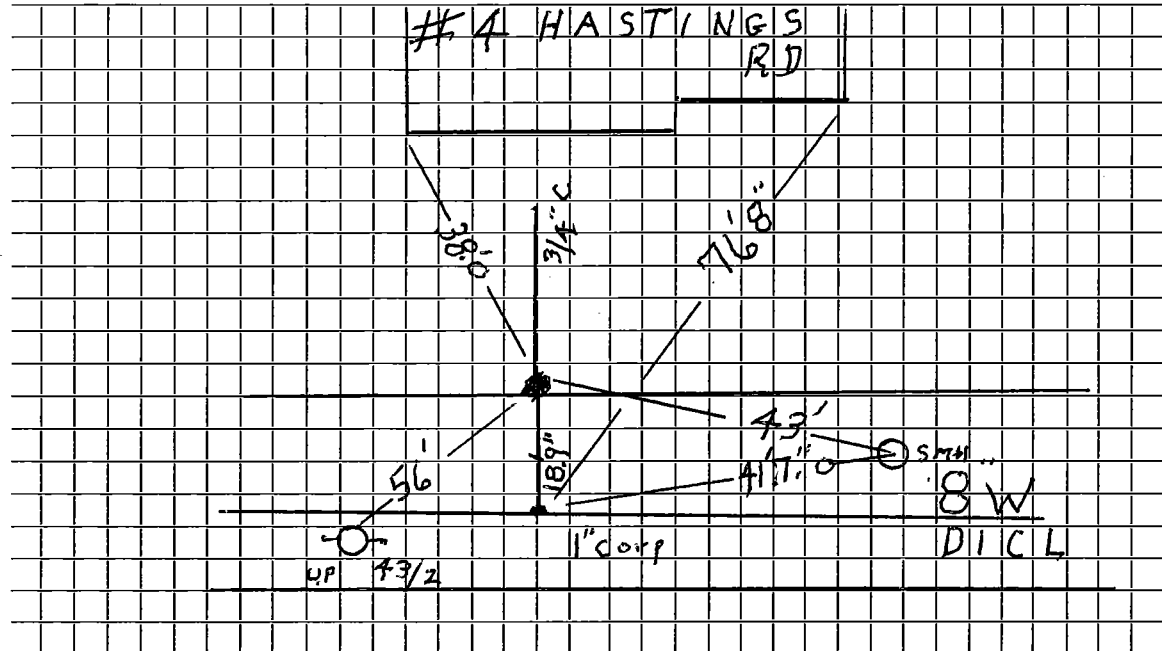

Connection made in Street.

Work completed 10/22/10 Grasse

Remarks:
.....
.....