


DATE _____

TOWN OF LEXINGTON — BOARD OF PUBLIC WORKS
WATER DIVISION

Sketch of Service Here

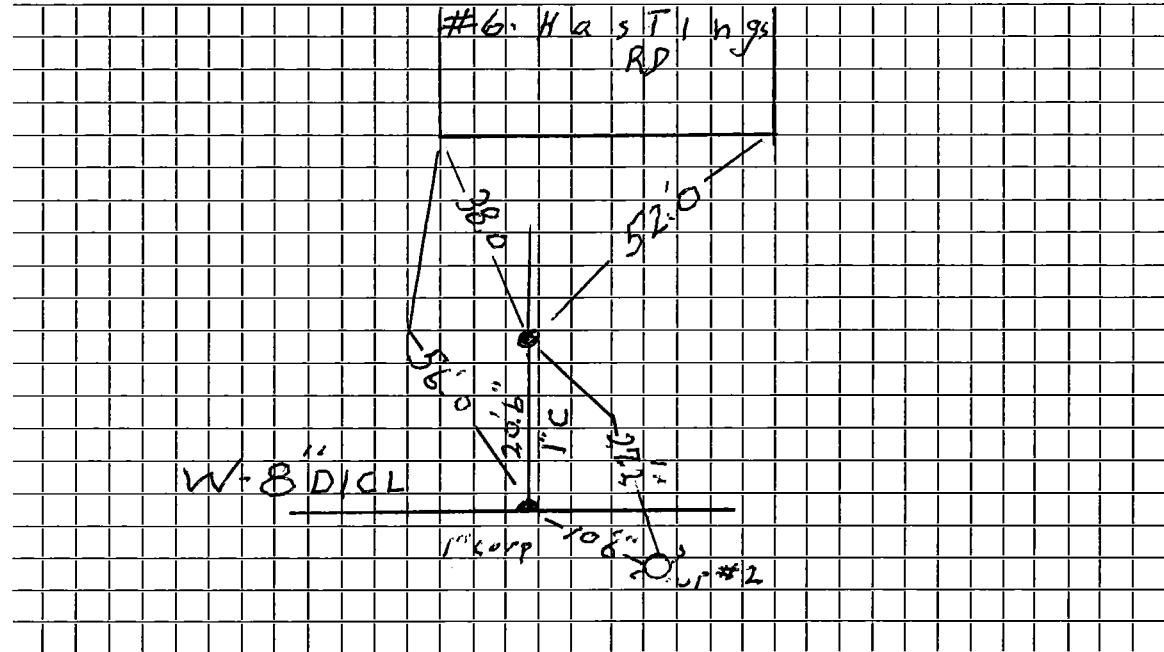

Connection made in Street. Work completed 10/21/10 Greense

Remarks: 2010 New 8" W-Main

.....
.....