

## WATER SERVICE RECORD

Name Esco Builders Corp.

Service No. 64

Address 10 Hathaway Road

# 2637

Location

Repair--Renewal--New Service


Comm 11-24-58

Date	Material	Amount	Total	Date	Amount
5/7/58	Labor	9 68		5-6-58	25 00
	10% overhead	97	10 65	5-24-58	13 33
	57' - 3/4" Copper tubing @ .37		21 09		38 33
	1 - 3/4" Cx 1/2 I.W.H. Stop & Waste		5 84		NON CHARGE
	1 hr. Trucking		75	Labor	5 89
			38 33	25' - 3/4" Copper tubing @ .37	9 25
				1 - 3/4" C. Corp Cock	4 64
				1 - 3/4" C. Curb Cock	6 03
				1 - 1/2" Straight tailpiece	50
				1 - 1/2" Offset tailpiece	50
					26 81

DATE \_\_\_\_\_

**TOWN OF LEXINGTON — BOARD OF PUBLIC WORKS**  
**WATER DIVISION**

Sketch of Service Here

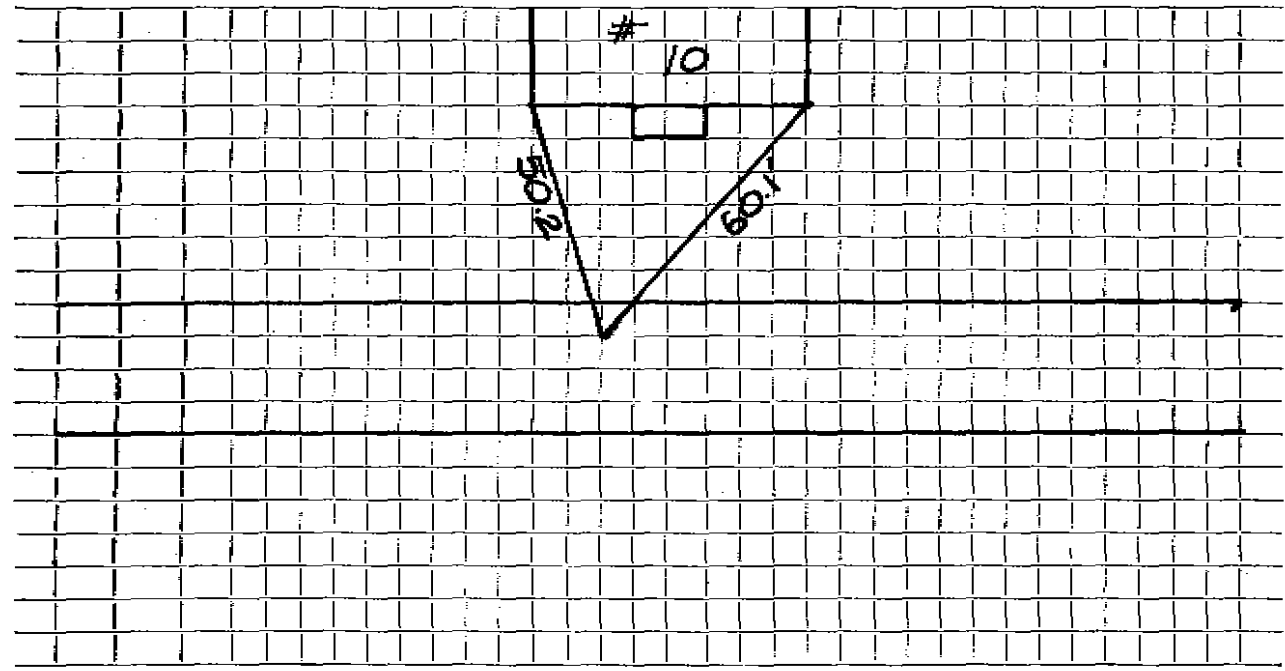

Connection made in ..... Street. Work completed .....

Remarks: .....  
.....  
.....