

WATER SERVICE RECORD

Name William Sullivan

Service No. 122

Address 11 Hathaway Road

# 2111

Location

~~Repair Renewal~~ New Service

Comm 11-24-58


Date	Material	Amount	Total	Date	Amount
6/25/58	Labor	1 85		6-20-58	25 00
	10% Overhead	19	2 04	6-11-58	1 89
	53'-3/4" Copper Tubing @.37	19 61		6-11-58	1 35
	1-3/4" Cx1/2 IWH stop & waste	5 84		2-25-59	NON CHARGE
	1 hr. Trucking @.75		75	6/25/58	28 24
			28 24	Labor	1 53
				10'-3/4" Copper Tubing @.37	3 70
				1-3/4" C Corp Cock	4 64
				1-3/4" C Curb Cock	6 03
				1 Box & Rod	5 00
				1-1/2 Straight Tailpiece	50
				1-1/2 Offset Tailpiece	50
					21. 90
					1.35

TOWN OF LEXINGTON — BOARD OF PUBLIC WORKS

WATER DIVISION

DATE \_\_\_\_\_

Sketch of Service Here

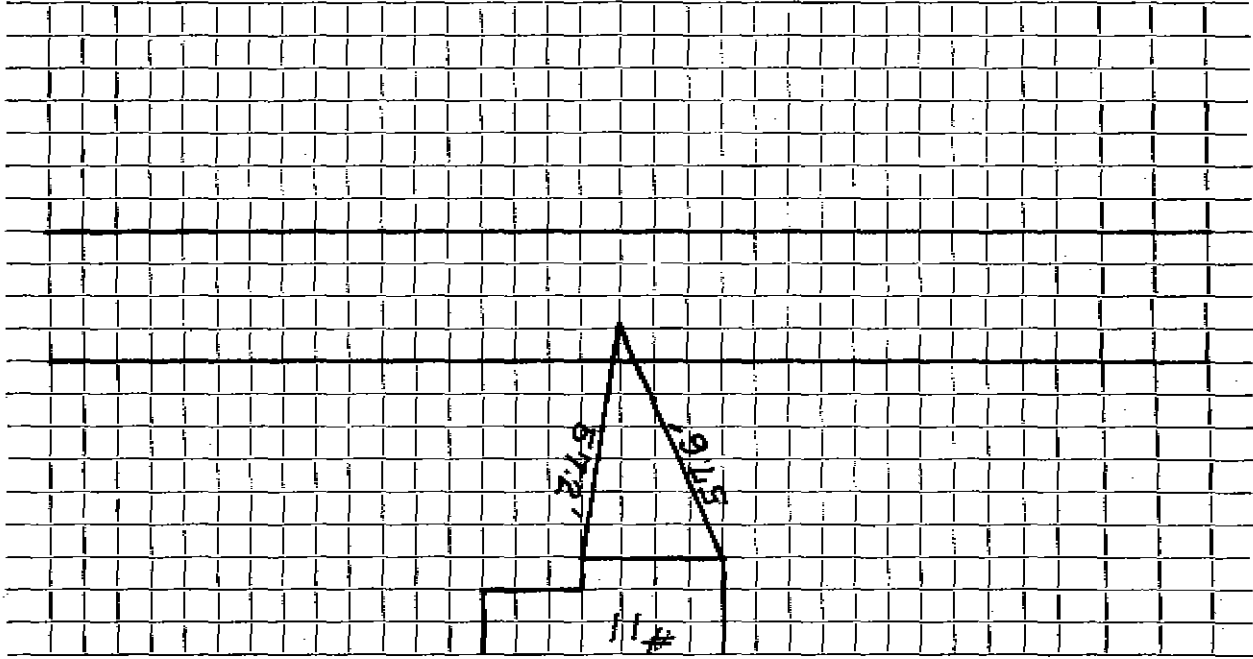

Street. \_\_\_\_\_ Work completed \_\_\_\_\_

Connection made in \_\_\_\_\_

Remarks: \_\_\_\_\_  
\_\_\_\_\_  
\_\_\_\_\_