

WATER SERVICE RECORD

#146

Name Esco Builders Corp.

Service No. 9

Address 12 Hathaway Road

Location

~~Renewal~~ ~~Extension~~ New Service

Comm 8-4-58

Date	Material	Amount	Total	Date		Amount
3-20-58	Labor	1.76		1-21-58	Deposit	30.00
	10% overhead	.18	1.94	2-4-58	Paid by W.H.C.#10	5.19
	100' 3/4" Copper tubing @.37		37.00			
	1 3/4" Cx 1/2" I.W.H. Stop & Waste		5.84		NON CHARGE	
	1 3/4" 3 part union		2.27	3-20-58	Labor	3.71
	1 hr. Trucking @.75	.75		46'	3/4" Copper tubing @.37	17.02
			47.80		1 3/4" C Corp. Cock	4.64
					1 3/4" C Curb Cock	6.03
					1 Box & Rod	5.00
					1 1/2" Straight tail piece	.50
					1 1/2" Offset tail piece	.50
						<u>37.40</u>

Bill [unclear] 7-11-58


R 5/

TOWN OF LEXINGTON — BOARD OF PUBLIC WORKS

WATER DIVISION

DATE

Sketch of Service Here

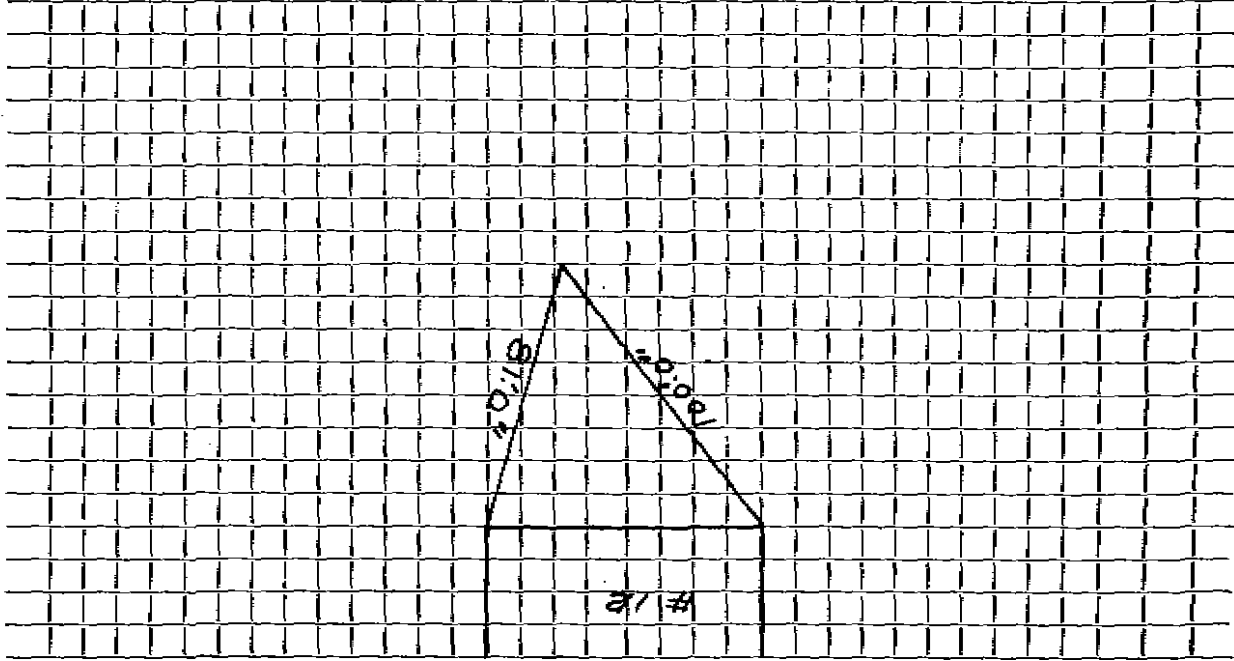

Connection made in

Street

Work completed

Remarks: