




DATE 5/31/2018

TOWN OF LEXINGTON — BOARD OF PUBLIC WORKS

WATER DIVISION

Sketch of Service Here

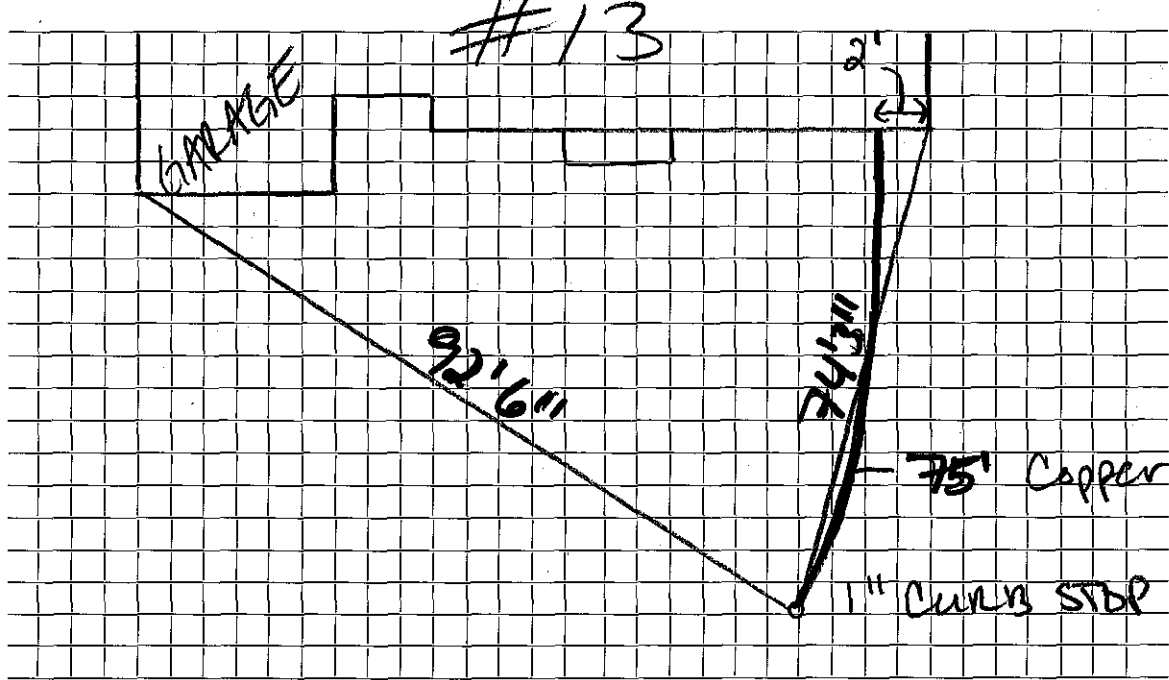

Connection made in Hathaway Street. Work completed .....

Remarks: .....