


TOWN OF LEXINGTON — BOARD OF PUBLIC WORKS
WATER DIVISION

Sketch of Service Here

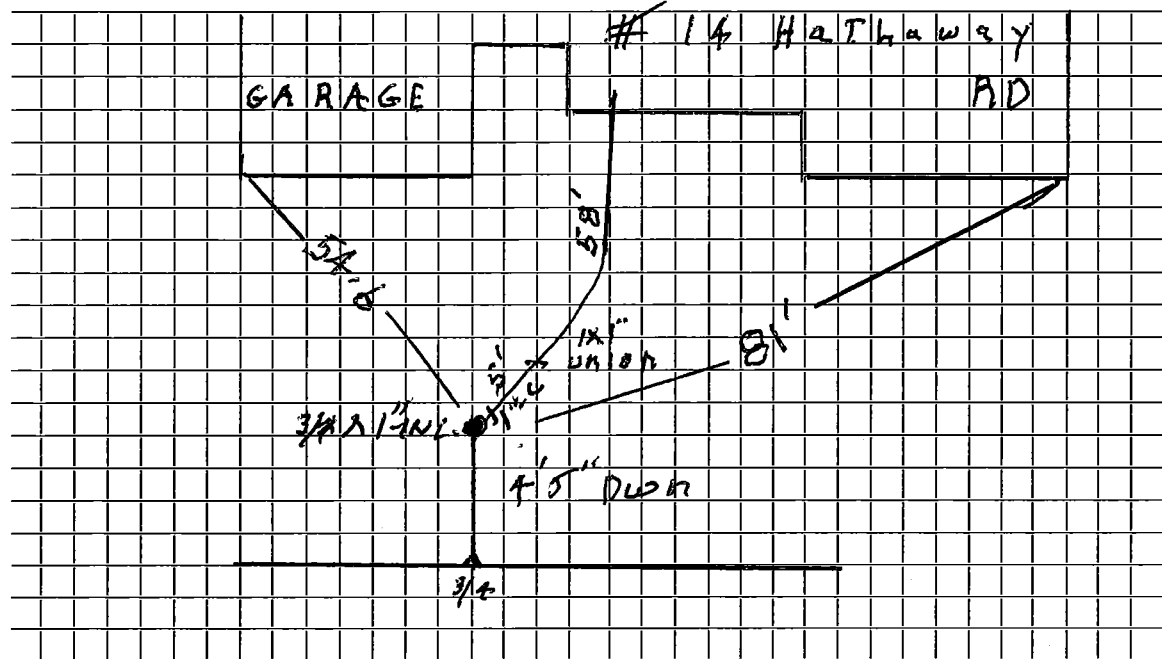

Connection made in..... Street.

Work completed 8/11/11 J. McLaughlin.....

Remarks:.....
.....
.....