

WATER SERVICE RECORD

Name

Service No. 1669

Address

15 HATHAWAY RD

Location

Teardown

Repair—Renewal—New Service


J. McLaughlin

Date	Material	Amount	Total	Date	Amount
12/9/64	54' 1" Copper			7'	3/4 Copper
Existing -	9'0" 3/4 Copper				3/4 Corp
	1 3/4x1" Union				3/4 Curbs Top
				EXIST - Box & Rod	

DATE \_\_\_\_\_

TOWN OF LEXINGTON — BOARD OF PUBLIC WORKS  
WATER DIVISION

Sketch of Service Here

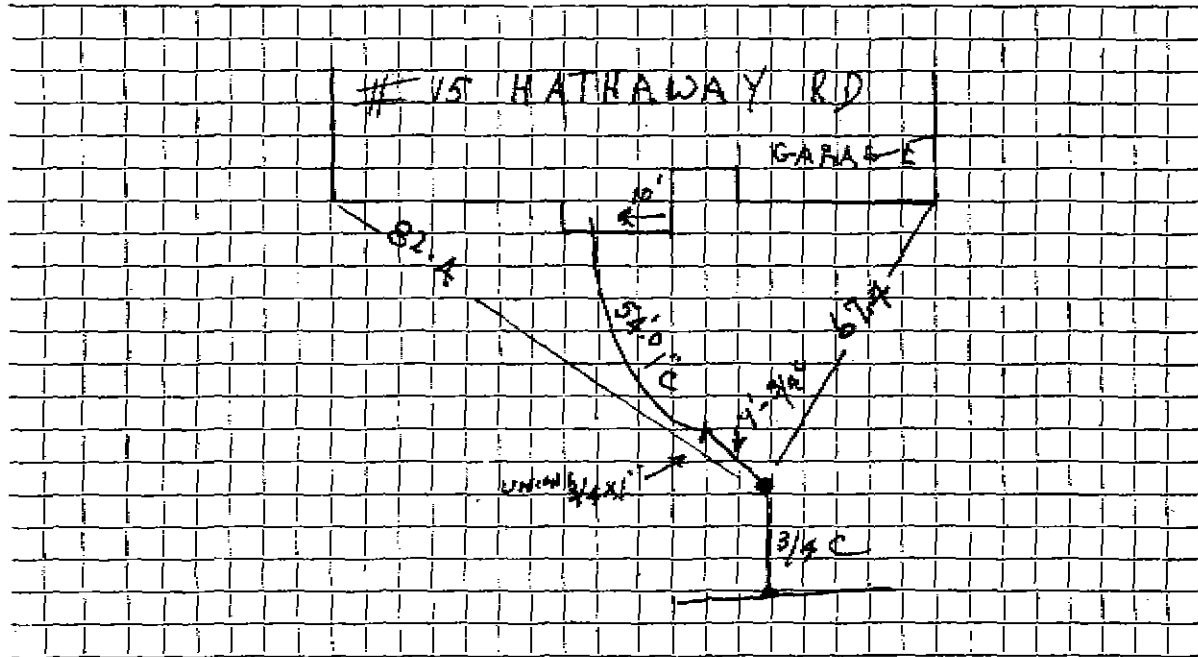

Connection made in *Back of sidewalk*.... Street.

Work completed *12/9/04*.....

Remarks: .....

.....

.....