

WATER SERVICE RECORD

Service No. 159

Name E. L. Eaton

Address 36 Hayes Avenue

Location

~~Repair~~ ~~Renewal~~ ~~New Service~~


Paid 11-24-60

| Date | Material | Amount | Total | Date | Amount | |
|---------|----------------------------------|--------|-------|----------|-----------------------------|-------|
| 9-16-60 | Labor | 32.78 | | 5-4-60 | 160.00 | |
| | 10% O.H. | 3.28 | 36.06 | 11-24-60 | 27.28 | |
| | 37' 3/4" Copper tubing @.42 | | 15.54 | | 72.77 | |
| 1 | 3/4" C X 1/2 I.W.B. Stop & Waste | | 6.27 | | | |
| 2 | hrs. Pippin Shovel @4.50 | | 9.00 | 9-16-60 | Labor | 28.36 |
| 2 | hrs. Trucking @3.00 | | 6.00 | | 32' 3/4" Copper tubing @.42 | 13.44 |
| | | | 72.77 | | 1 3/4" C Curb Cock | 6.28 |
| | | | | | 1 3/4" C Corp Cock | 4.91 |
| | | | | | 2 hrs. Pippin Shovel @4.50 | 9.00 |
| | | | | | 21 x 3 Patch | 21.00 |
| | | | | | | 82.99 |

DATE _____

TOWN OF LEXINGTON — BOARD OF PUBLIC WORKS
WATER DIVISION

Sketch of Service Here

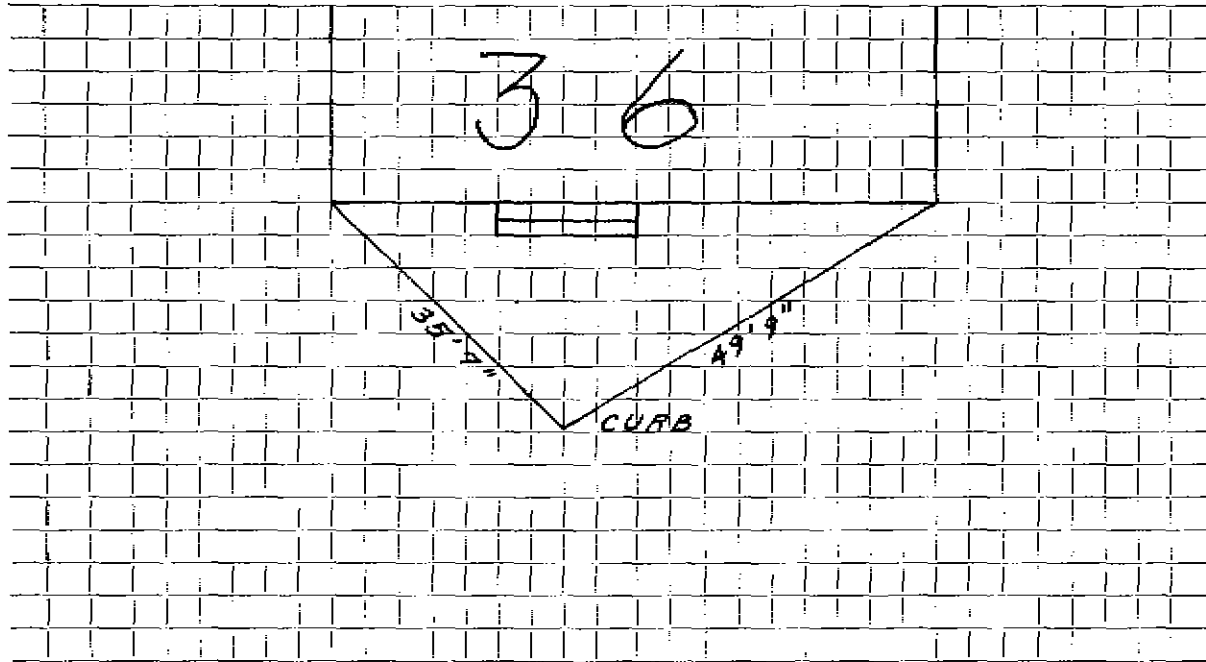

Connection made in Street. Work completed

Remarks:
.....
.....