


DATE 4/2017

TOWN OF LEXINGTON — BOARD OF PUBLIC WORKS

WATER DIVISION

Sketch of Service Here

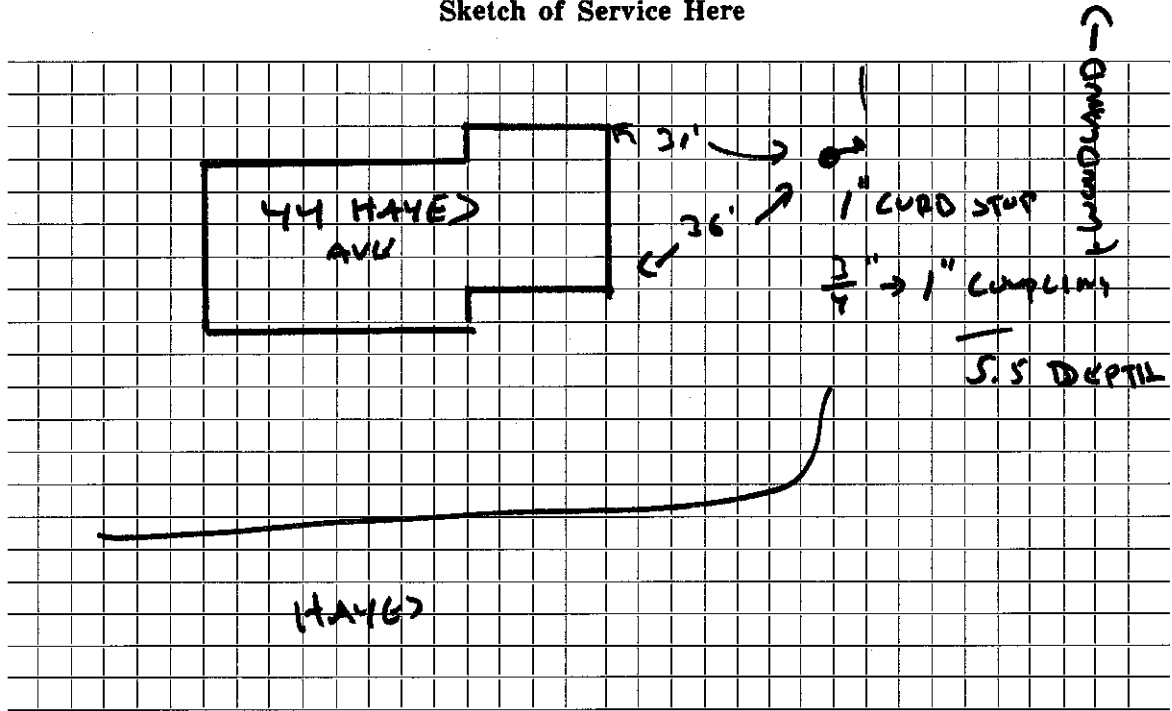

Connection made in WOODLAND Street. Work completed FERRANTE CONSTRUCTION

Remarks:

.....

.....

WATER SERVICE RECORD

Name

Service No.

Address **44 BAYES**

FURNACE

Location

Repair ~~Renewal~~ — New Service

Date	Material	Amount	Total	Date	Amount
7/17	1" TYPE IC COPPER				
	1" CURB STOP				
	CAMP BROS				
	OPEN (R)				
	1" → 3/4" COUPLING				
	BUFFALO BOX				