


DATE 10/28/20

TOWN OF LEXINGTON — BOARD OF PUBLIC WORKS

WATER DIVISION

Sketch of Service Here

~~XXXXXXXXXX~~ # 6 Hayes

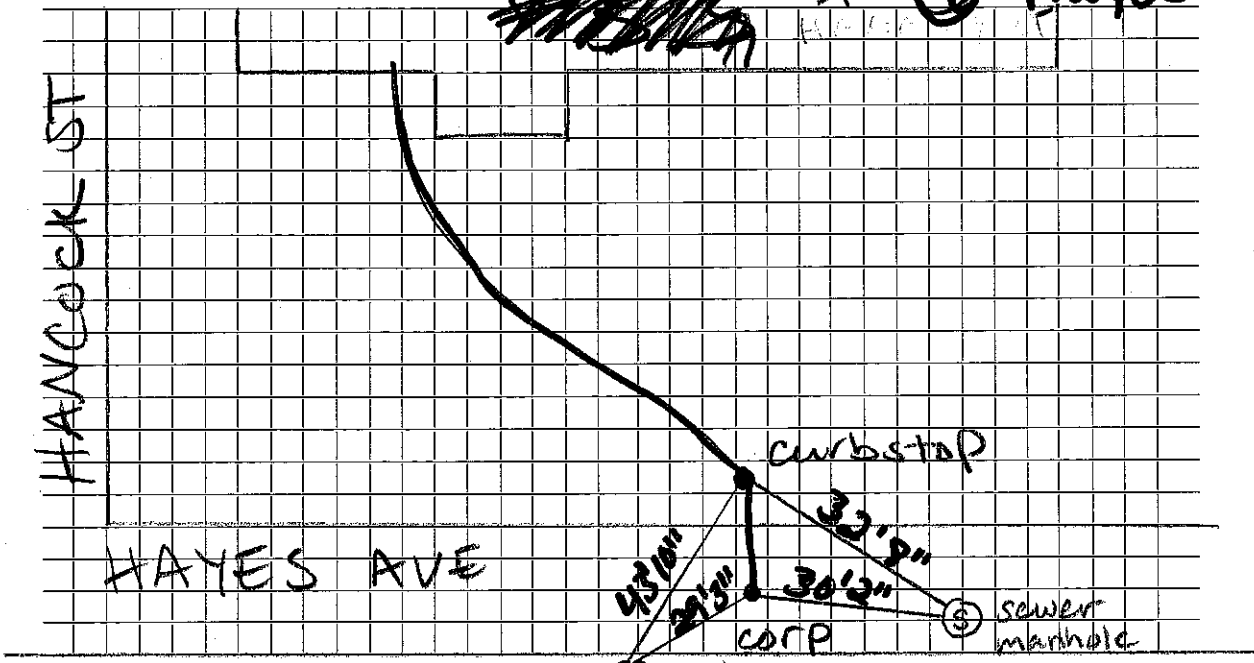

Connection made in Hayes Ave Street. Work completed

Remarks: