

WATER SERVICE RECORD

Name

Service No.

Address 10 HAYES LANE

Location Permit # 1411


Repair—Renewal—New Service

Date	Material	Amount	Total	Date	Amount
	INSIDE				outside
6/23/00	50' 1" COPPER			12/27/87	11'6" # 3/4" COPPER
	1 3/4" X 1" UNION				1 3/4" CURB
					1 3/4" COPP
				6/23/00	1 BUFF BOX

DATE 6/26/00

TOWN OF LEXINGTON — BOARD OF PUBLIC WORKS
WATER DIVISION

Sketch of Service Here

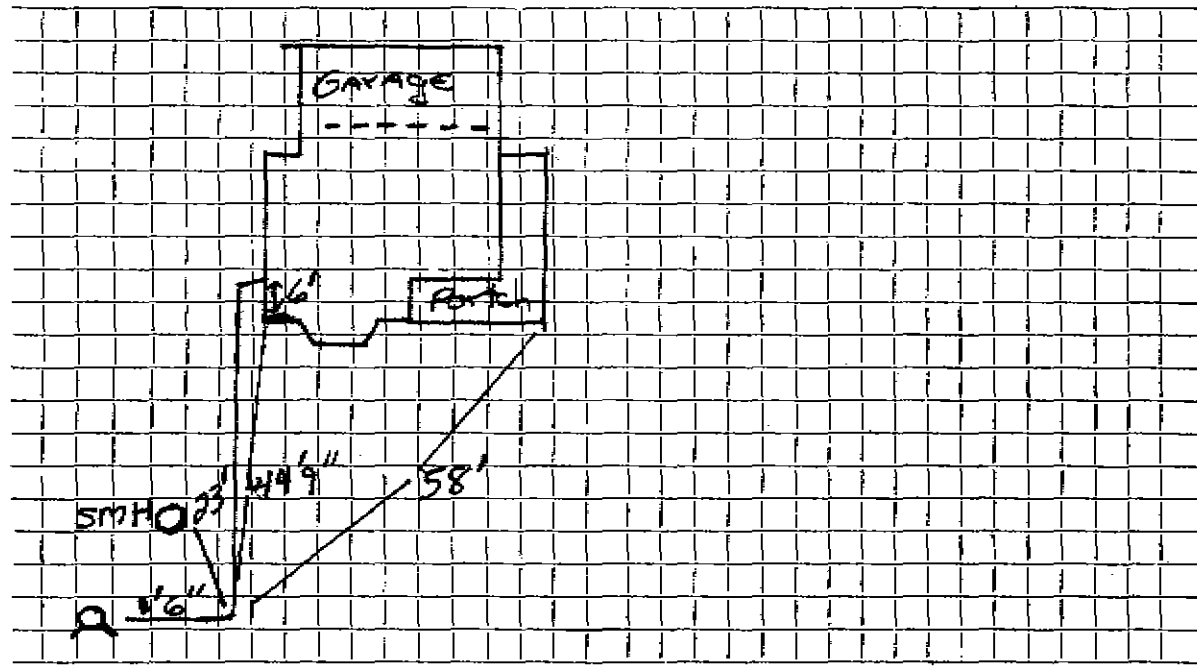

Connection made in Street. Work completed

Remarks:
.....
.....