


DATE _____

TOWN OF LEXINGTON — BOARD OF PUBLIC WORKS

WATER DIVISION

Sketch of Service Here

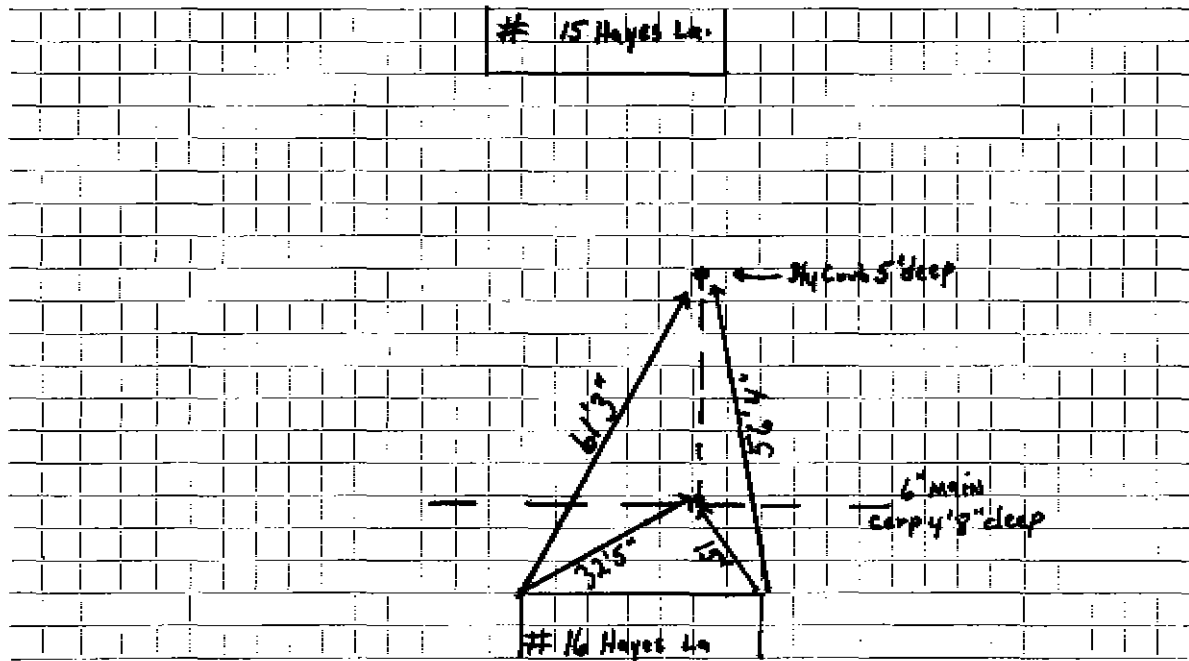

Connection made in Street. Work completed

Remarks: Service for 15 Hayes Ln Taped in front Lawn of No-16

Gas - Water + Sewer in same easement