

WATER SERVICE RECORD

Name

Service No.

Address *2 Hayes Lane*

Location

Repair—Renewal—New Service

Date	Material	Amount	Total	Date	Amount
<i>4/7/50</i>	<i>1" COPPER 1 1/2" VALVE S+W 1x 3/4 BUSHING 2- 3/4 TRAILPIECE</i>				
				<i>OUTSIDE</i>	
				<i>12/28/87</i>	<i>12.8</i>
				<i>1</i>	<i>1" Copper</i>
				<i>1</i>	<i>1" Compression Curb</i>
				<i>1</i>	<i>1" - 3/4" Corp Adaptor</i>
				<i>1</i>	<i>3/4" Corp.</i>
				<i>1</i>	<i>Box & Rod</i>


DATE _____

TOWN OF LEXINGTON — BOARD OF PUBLIC WORKS

WATER DIVISION

Sketch of Service Here

HAYES LA.

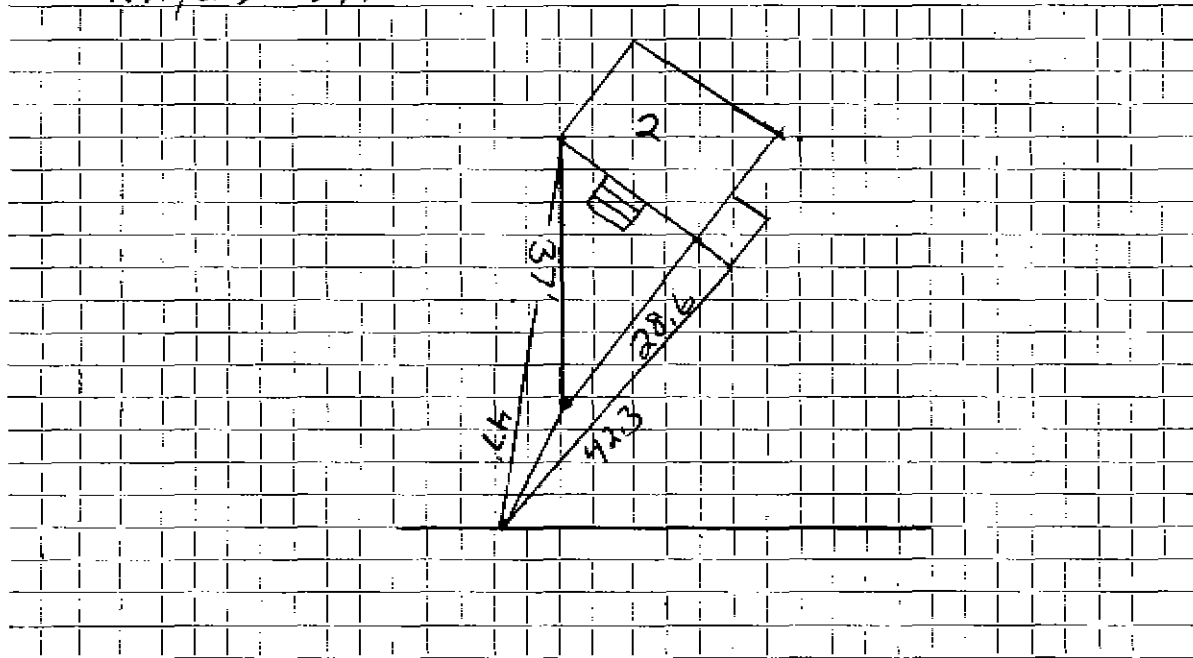

Connection made in Street. Work completed

Remarks: 5'6" Deep