

WATER SERVICE RECORD

Name Paul Tocci

Service No. 115

Address 22 Hayes Lane

Location

~~Repair~~ ~~Extend~~ New Service

June 8-3-59


Date	Material	Amount	Total	Date	Amount
6-5-59	Labor	2.14		6-5-59	50.00
	10% O.H.	.21	2.35	8-3-59	24.08
45'	3/4" Copper tubing @ .3764		16.94		25.92
1	3/4" C x 1/2" I.W.H. Stop & Waste		5.88		NON CHARGE
1	hr. Trucking @ .75		.75		Labor
			25.92		1.95
				10'	3/4" Copper tubing @ .3764
				1	3/4" C Corp Cock
				1	3/4" C Curb Cock
				1	Box & Rod
				1	3/8" Straight tailpiece
				1	3/8" Offset tailpiece
					22.45

DATE _____

TOWN OF LEXINGTON — BOARD OF PUBLIC WORKS

WATER DIVISION

Sketch of Service Here

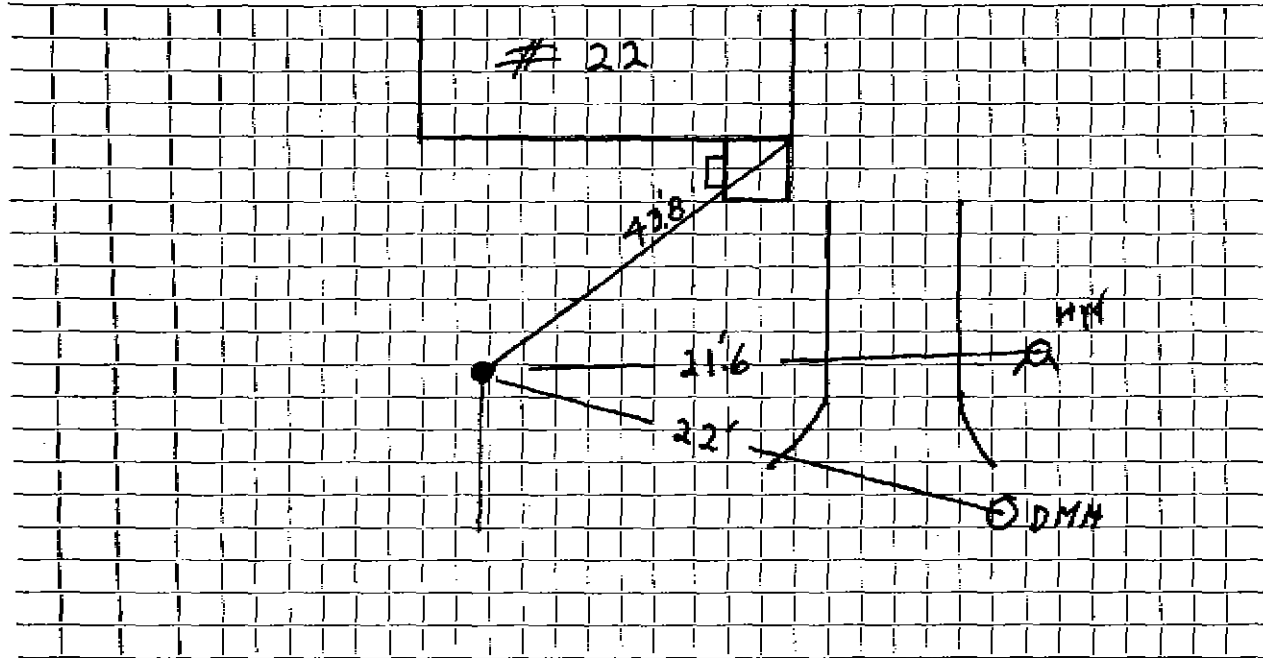

Connection made in Street. Work completed

Remarks:
.....
.....