

WATER SERVICE RECORD

Name George R. Limbrick Jr.

Service No. 87

Address 23 Hayes Lane

Location

~~Repair/~~ Renewal—New Service W.O. #6021

**AUG 5 1968**

Date		Material	Amount	Total	Date	Amount
1-3-67	35'	3/4" Copper tubing			12-18-67	25 00
					8-5-68	9 42
12/28/67		Labor	10 70			65 58
		10% O.H.	1 07	11 77		
	38'	3/4" copper tubing @ .79		30 02		
	1	3/4" Corp Cock		7 42		
	1	3/4" Curb Stop		8 37		
	1	Box & Rod		5 10		
	2	Bags Rockwool @ 1.45		2 90		
				65 58		


*Deposit*  
*Refund*

DATE \_\_\_\_\_

# TOWN OF LEXINGTON — BOARD OF PUBLIC WORKS

## WATER DIVISION

Sketch of Service Here

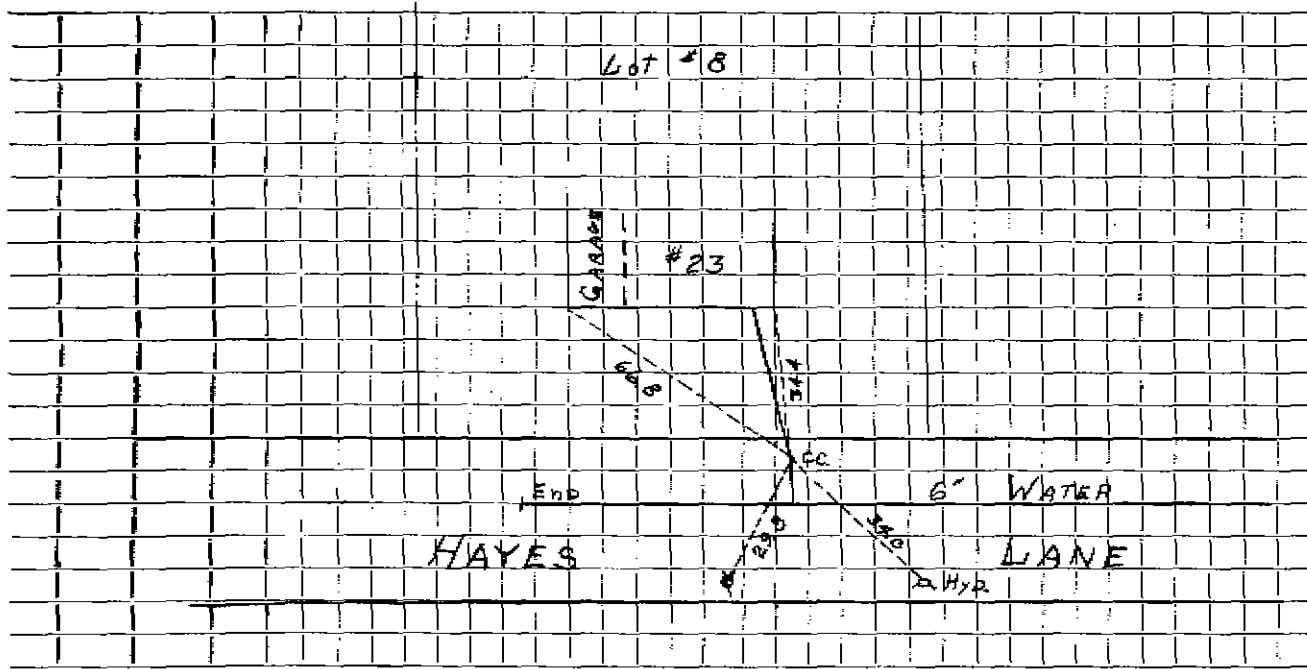

Connection made in ..... Street. Work completed .....

Remarks: .....

.....

.....