

### WATER SERVICE RECORD

**Name** C. W. Morgan Co Inc.

**Service No.**

**Address** 26 Hayes Lane


**Location** Lot E

~~Repair-Renewal~~ **New Service** Surianello #4504

| Date     | Material             | Amount | Total | Date     | Amount           |
|----------|----------------------|--------|-------|----------|------------------|
| 11/15/83 | 89' 1" Copper tubing |        |       |          |                  |
|          | 1 1" Union Flare     |        |       |          |                  |
|          |                      |        |       | OUTSIDE  |                  |
|          |                      |        |       | 11/15/83 | 43'              |
|          |                      |        |       |          | 1" Copper tubing |
|          |                      |        |       |          | 1" Corp          |
|          |                      |        |       |          | 1" Curb          |
|          |                      |        |       |          | Box & Rod        |

TOWN OF LEXINGTON — BOARD OF PUBLIC WORKS  
WATER DIVISION

Sketch of Service Here

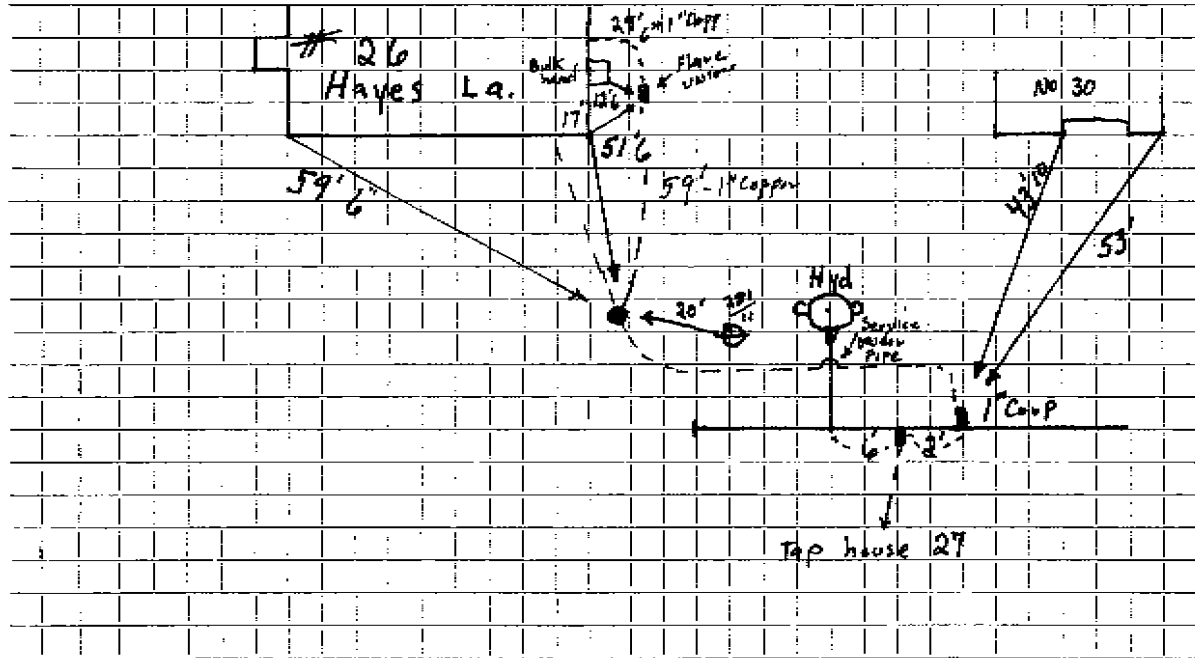

Connection made in ..... Street. Work completed .....

Remarks: .....  
.....  
.....