

WATER SERVICE RECORD

#5395

Name A. Purney Acker

Service No. 172

Address 27 Hayes Lane

#2243

Location

Repair—Renewal—New Service


Comm. 11-18-57

Date	Material	Amount	Total	Date	Amount	
8/21/57	Labor	34 31		8-12-57	Deposit	\$ 125 00
	10% overhead	3 43	37 74	11-18-57	Refund	35 78
	90' - 3/4" Copper tubing @ .375		33 75		NON CHARGE	\$ 89 22
	1 - 3/4" Cx 1/2 I.W.H. Stop & Waste		4 96	8/21/57	Labor	9 53
	1 - 3/4" C. Union (3 part)		2 27	25' - 3/4" Copper tubing @ .375		9 38
	1 hr. Trucking		75	1 - 3/4" C. Corp Cock		4 64
	1 1/2 hrs. Town Shovel @ 6.50		9 75	1 - 3/4" C. Curb Cock		5 94
			89 22	1 Box & Rod		4 62
				1 - 1/2 Straight tailpiece		50
				1 - 1/2 Offset tailpiece		50
				1/2 hr. Town Shovel @ 6.50		3 25
						38 36

DATE \_\_\_\_\_

TOWN OF LEXINGTON — BOARD OF PUBLIC WORKS  
WATER DIVISION

Sketch of Service Here

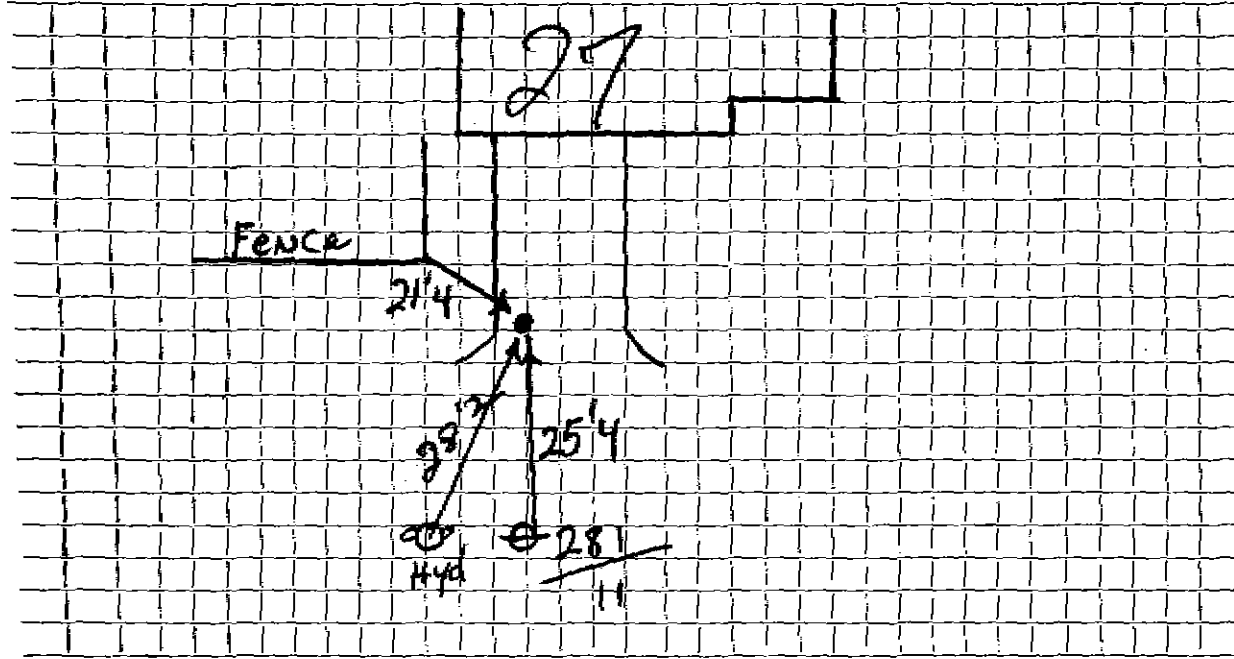

Connection made in ..... Street. Work completed .....

Remarks: .....  
.....  
.....