

WATER SERVICE RECORD

Name W. Aker

Service No.

Address 29 HAYES LANE

Location

Repair Renewal New Service

Bruce McKee #0403


Date	Material	Amount	Total	Date	Amount
11/17/94	31 LF 3/4" COPPER				
				8-8-57	
					1 3/4" X 3/4" - 3 Part Union
					1 3/4" C. Corp Cock
					1 3/4" X 4" C. L. ^{NIPPLE} Coupling
					1 3/4" Style 38

DATE 6/2/95

TOWN OF LEXINGTON — BOARD OF PUBLIC WORKS

WATER DIVISION

Sketch of Service Here

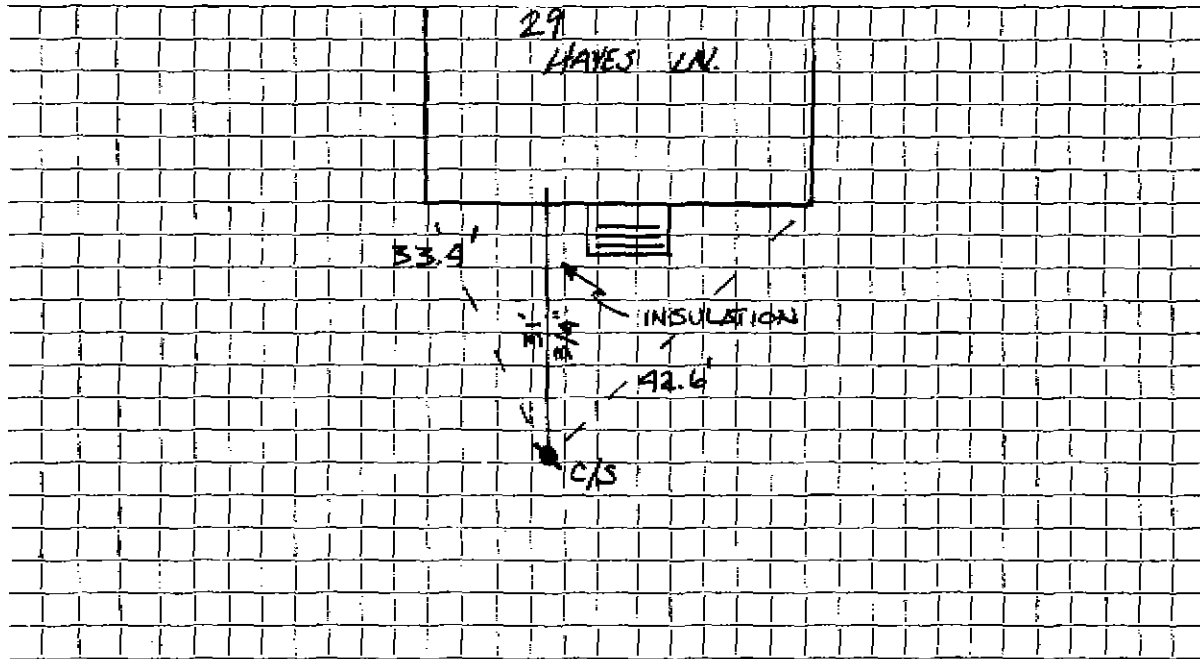

Connection made in HAYES LANE Street. Work completed

Remarks: