Water Service Record

Name				Service No.
Address	31 Haves has	ne.		


Location

Repair - Renewal - New Service

Date	Material	Amount	Total	Date	Amount
8/29/23	1" K copper 1" curb stop Buffalo Box	47			
	1" curb stop				
	Buffalo Box				

Date: 8/29/23

TOWN OF LEXINGTON - BOARD OF PUBLIC WORKS WATER DIVISON

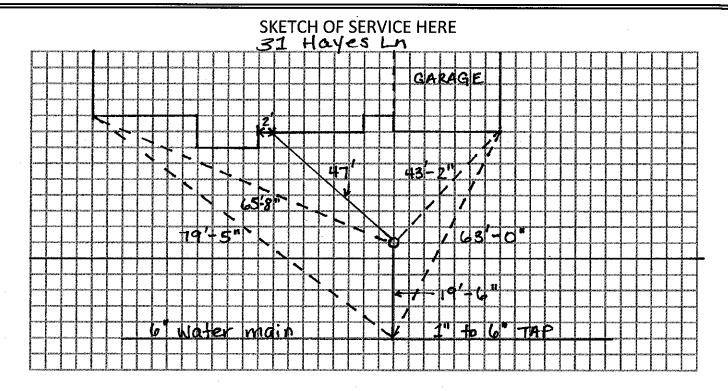

Connection made in:	Street.	Work completed:	
Remarks: Installed by J. M.	McLauahlin	Inc.	
	J		A CONTRACTOR OF THE PROPERTY O