

WATER SERVICE RECORD

Name George McCormack

Service No. 185

3011
3127

Address 32 Hayes Lane

Location

Repair ~~Renewal~~ — New Service


Comm. 10-8-56

| Date | Material | Amount | Total | Date | Amount |
|---------|-----------------------------------|--------|-------|-------------------------------|------------|
| 7/26/56 | Labor 10% overhead | 17 30 | | 7-9-56 Deposit | 75 00 |
| | 50' 3/4" Coppertubing @ .4850 | 24 25 | | 7-8-56 Refund | 10 24 |
| | 1 3/4" x 1/2" I.W.H. Stop & Waste | 4 96 | | | 64 76 |
| | 1 hr. trucking | 75 | | | Labor 8 09 |
| | 2 hrs. Littlefield @ 8.50 | 17 00 | | 15' 3/4" Coppertubing @ .4850 | 7 28 |
| | | 64 76 | | 1 3/4" Corp. Cock | 4 64 |
| | | | | 1 3/4" Curb " | 5 94 |
| | | | | 1 Box & Rod | 4 62 |
| | | | | 1 1/2" Straight Tail Piece | 50 |
| | | | | 1 1/2" Offset " " | 50 |
| | | | | 1 hr. Littlefield @ 8.50 | 8 50 |
| | | | | | 40 07 |

DATE _____

TOWN OF LEXINGTON — BOARD OF PUBLIC WORKS
WATER DIVISION

Sketch of Service Here

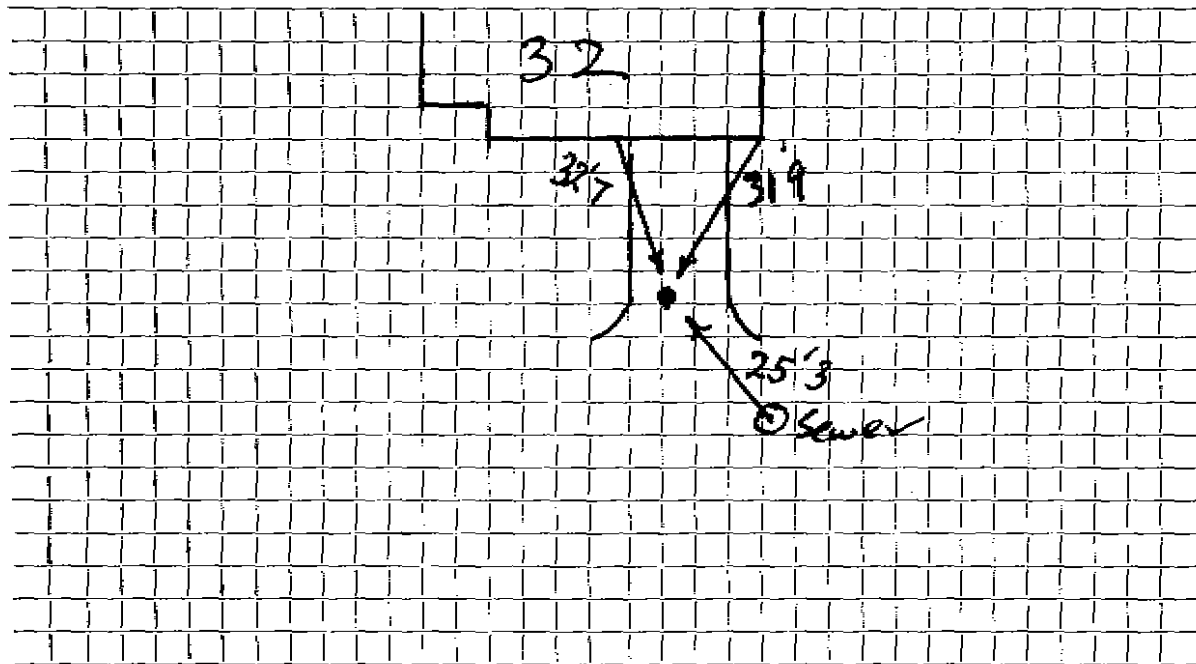

Connection made in Street. Work completed

Remarks:
.....
.....