




Date: 8/30/23

TOWN OF LEXINGTON - BOARD OF PUBLIC WORKS  
WATER DIVISION

SKETCH OF SERVICE HERE  
33 Hayes Lane

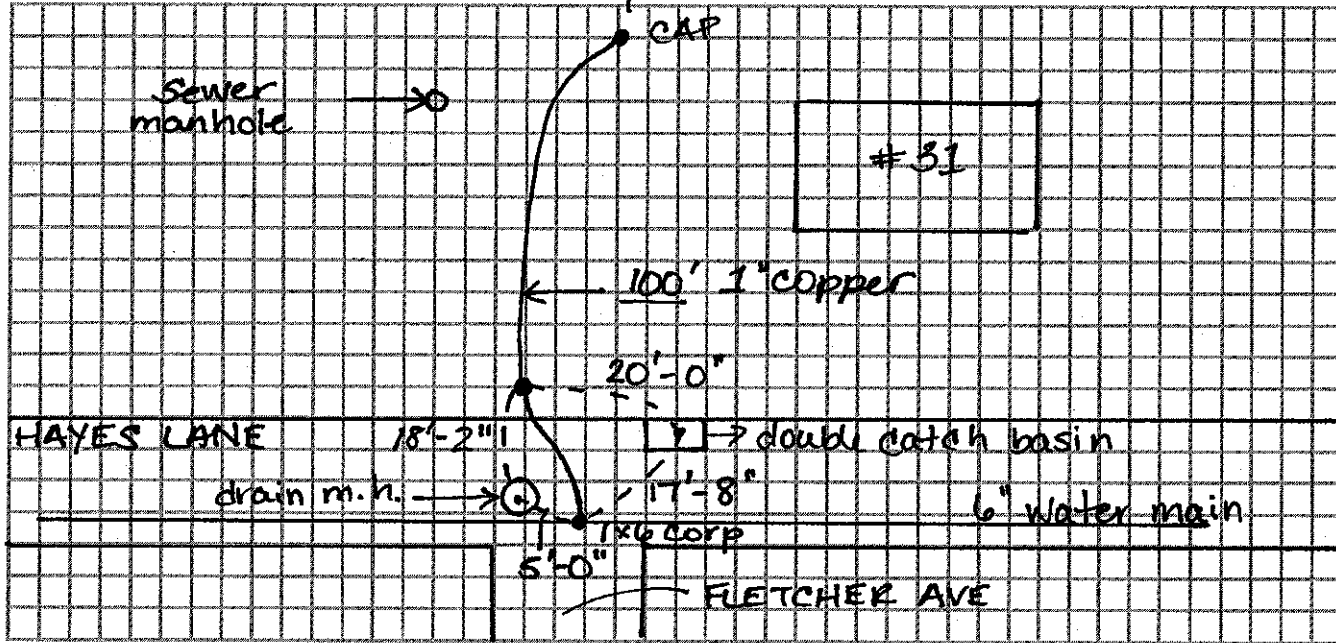

Connection made in:

Street.

Work completed:

Remarks: Installed by J.M. McLaughlin Inc.