

WATER SERVICE RECORD

Name John Ingraham

Service No. 

Address 35 Hayes Lane

Location

~~Repair~~ Renewal—New Service


Date	Material	Amount	Total	Date	Amount
	Renewed by Arlex #4516				
5/16/84	143' 1" Copper				
	1 1" Union				
	1 1" x 3/4" Valve				
	1" to 1 1/8" Increased at curb			5-19-59	
					NON CHARGE
					Labor
					33 83
				15'	3/4" Copper Tubing @3.66 5 50
				1	3/4" C Curb Cock 6 03
				1	1" Coupling 54
				1	Box & Rod 5 00
				2	Hrs. Pippin Shovel 4.50 9 00
				1	Hr. Trucking @ 75 75
				2	Hrs. Pump @ 1.00 2 00
					<u>62 25</u>

DATE _____

TOWN OF LEXINGTON — BOARD OF PUBLIC WORKS

WATER DIVISION

Sketch of Service Here

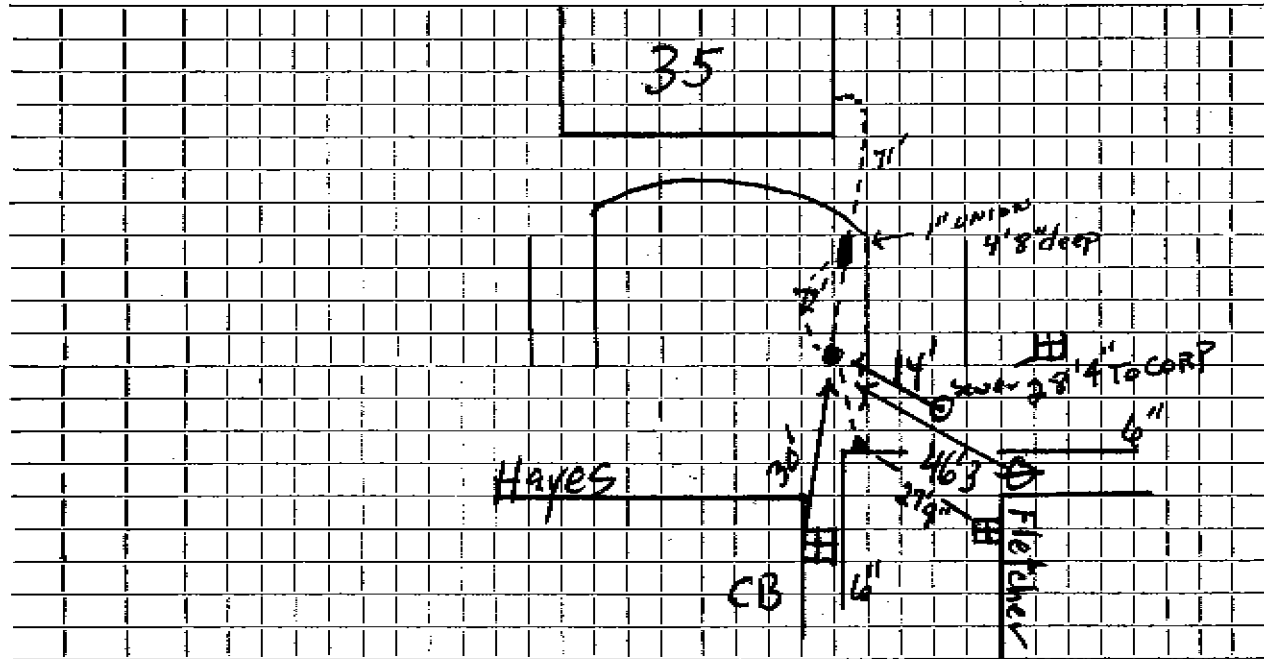

Connection made in cut is only 3' x deep Street. Work completed

Remarks: 3/4 Copper & curb outside, 1" inside

CORP IS 4' DWN. COPPER GOOSE NECK 3' 8" dwn w/insul