

Name W. Lichtenberg

Service No. ~~1225~~ 1230

Address 6 Hayes Lane, Lexington

Location 6 Hayes Lane

Kind of Pipe

Size

Size of Main

Repair—Renewal—New Service

Location

Date
1941

Material

Amount

Total

Date

Amount

Nov. 8

2 hrs. @ 60¢

1 20

October 7, 1941

Deposited

10 00

10% Overhead

12

1 32

22' 3/4" Copper tubing @ 19¢

4 18

1 3/4" C.x 1/2" I.S. & W.

2 50

1 3/4" C. Union (3 part)

1 00

1 3/4" C.x 3/4" I/Union (2 part)

70

1 hr. trucking

75

10 45

Charge: \$10.00

Labor

Renewal

DATE Oct 27, 1941

TOWN OF LEXINGTON—BOARD OF PUBLIC WORKS

WATER DIVISION

The undersigned applies for a supply of water at No. 6 Hayes Lane St. and hereby agrees to comply with the rules and regulations as now, or at any future time, established by the Board of Selectmen.

Am't. of Estimate \$ 10⁰⁰


Owner V. Sichtenberg

Am't. Paid \$ _____

Address _____

Builder _____

Sketch of Service Here

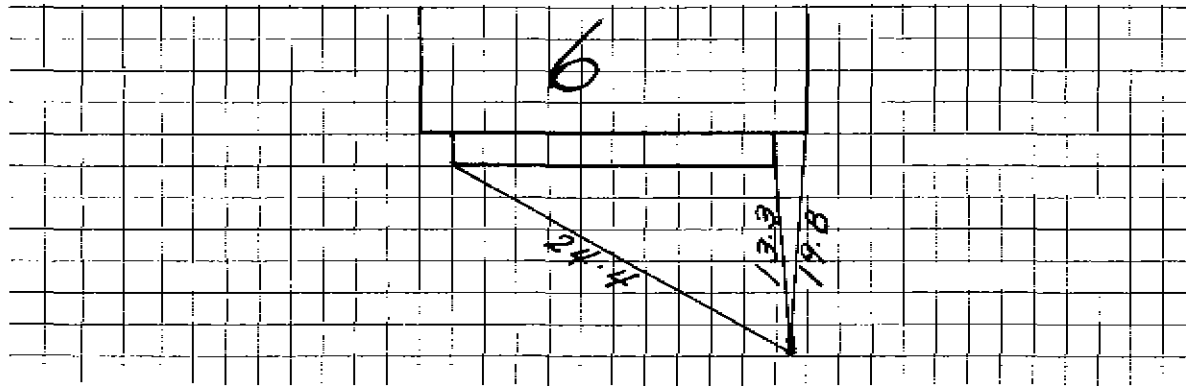

Connection made in _____ Street.

Work completed _____ 19

Remarks: