

**WATER SERVICE RECORD**

Name

Service No.

Address

7 Hayes Lane

Location

Repair—Renewal—New Service


| Date    | Material        | Amount | Total | Date     | Amount                         |
|---------|-----------------|--------|-------|----------|--------------------------------|
| 7/26/61 | 53' 3/4" Copper |        |       |          |                                |
|         | 1 3/4" Corp     |        |       |          |                                |
|         | 1 3/4" Curb     |        |       |          |                                |
|         | 1 Box & Rod     |        |       |          |                                |
|         |                 |        |       |          | <b>OUTSIDE RENEWED BY TOWN</b> |
|         |                 |        |       | 12/23/87 | 23' 3/4" Copper                |
|         |                 |        |       | 1        | Style 88 3/4"                  |
|         |                 |        |       | 1        | 3/4" Corp.                     |

DATE \_\_\_\_\_

TOWN OF LEXINGTON — BOARD OF PUBLIC WORKS

**WATER DIVISION**

Sketch of Service Here

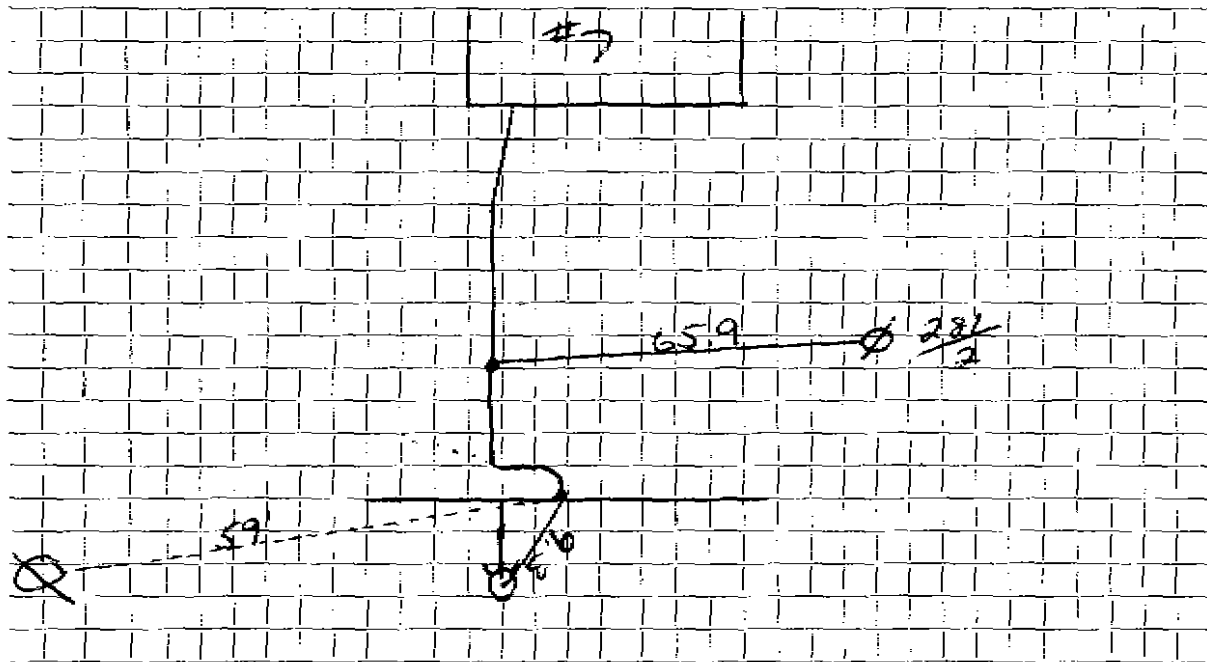

Connection made in ..... Street. Work completed .....

Remarks: .....

.....

.....