

## WATER SERVICE RECORD

#3757

Name William H. Sullivan

Service No. 55

Address 19 Hayward Avenue (Mail--14 Milk St., Lex.)

Location

~~Repair~~ ~~Renewal~~ New Service


Comm. 6-10-57

Date	Material	Amount	Total	Date	Amount
4/5/57	Labor	13 68		4-2-57	Deposit 75 00
	10% overhead	1 37	15 05	6-10-57	Refund 33 07
	27' 3/4" Copper tubing @.4228		11 42		\$ 41 93
	1 3/4" C x 1/2 I.W.H. Stop & Waste		4 96		<u>NON CHARGE</u>
	1 1/2 Hr. Town Shovel @6.50		9 75	Labor	3 23
	1 Hr. Trucking @.75		75	15' 3/4" Copper tubing @.4228	6 34
			41 93	1 3/4" C Corp Cock	4 64
				1 3/4" C Curb Cock	5 94
				1 Box & Rod	4 62
				1 1/2 Straight tail piece	50
				1 1/2 Offset tail piece	50
				1/2 Hr. Town Shovel @6.50	3 25
					29 52

DATE \_\_\_\_\_

TOWN OF LEXINGTON — BOARD OF PUBLIC WORKS  
**WATER DIVISION**

Sketch of Service Here

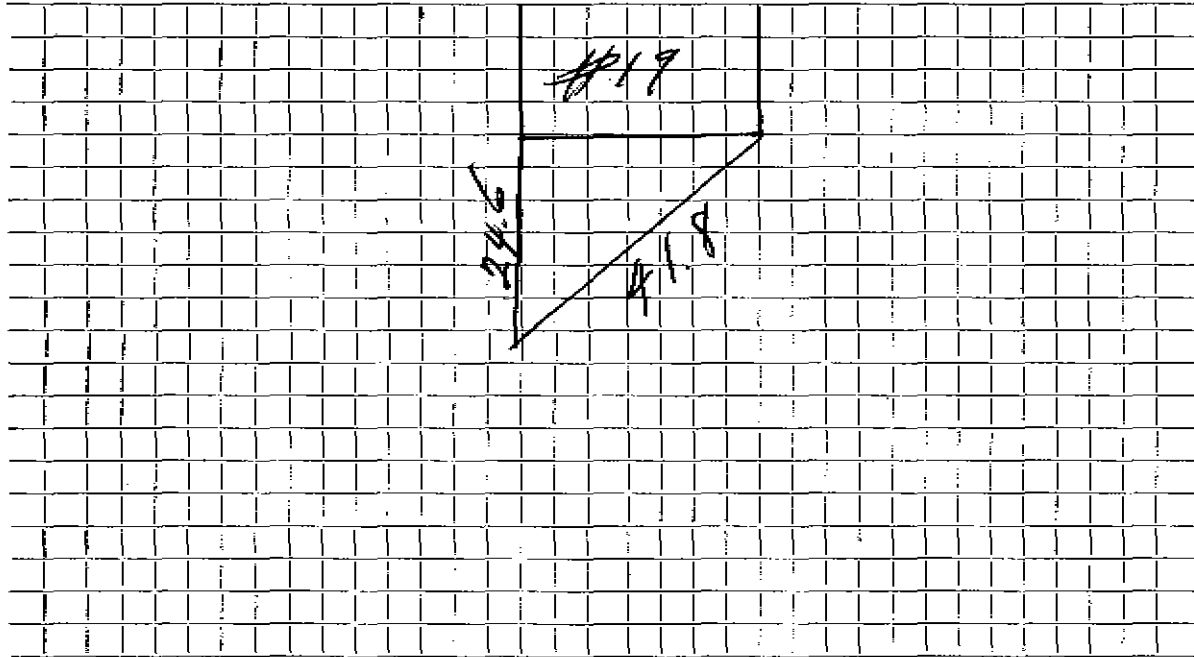

Connection made in ..... Street. Work completed .....

Remarks: .....

.....

.....