

WATER SERVICE RECORD

Name Dianne Estates Inc.

Service No. 97

Address 25 Hayward Ave.

3119

Location

~~Repair~~ ~~Renewal~~ New Service

Comm 7-6-59


Date	Material	Amount	Total	Date	Amount	
5-20-59	Labor	2 10		5-18-59	Deposit	50 00
	10% O. H.	21	2 31	7-6-59	Retard	27 50
37'	3/4" Copper Tubing @.3666		13 56			22 50
1	3/4" C x 1/2 IWH Stop & Waste		5 88		<u>NON CHARGE</u>	
1	Hr. Trucking @.75		75	5-20-59	Labor	9 50
			22 50	5'	3/4" Copper Tube @.3666	1 83
				1	3/4" C Corp Cock	4 67
				1	3/4" C Curb Cock	6 07
				1	Box & Rod	5 00
				1	Hr. Town Shovel	6 50
				1	Hr. Trucking @.75	75
				1	1/2 Straight Tailpiece	50
				1	1/2 Offset Tailpiece	50
						35 32

DATE _____

TOWN OF LEXINGTON — BOARD OF PUBLIC WORKS

WATER DIVISION

Sketch of Service Here

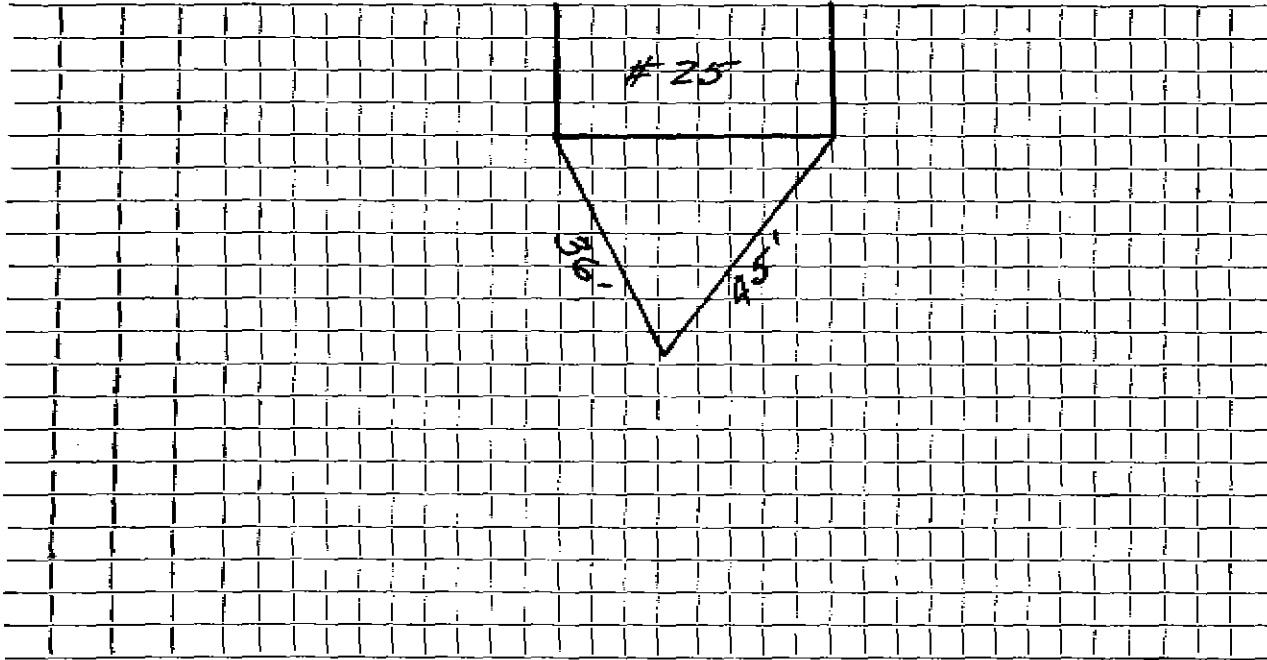

Connection made in Street. Work completed

Remarks:
.....
.....