

## WATER SERVICE RECORD

# 4391

Name William Sullivan

Service No. 342 (1956)

Address 27 Hayward Avenue

Location

~~Water Service~~ New Service

Comm. 4/1/56


Date	Material	Amount	Total	Date	Amount
11-11-56	Labr			11-8-56	Deposit #30.00
	40' 3/4" Copper tubing @ .4396		17.58	4-1-57	Refund * 7.46
	1 3/4" C x 1/2 I.W.H. Stop & Waste		4.96		# 22.54
			22.54		NON CHARGE
					10' 3/4" Copper tubing @ .4396 4.40
					1 3/4" C Corp Cock 4.64
					1 3/4" C Curb Cock 5.94
					1 Box & Rod 4.62
					1 1/2 Straight tail piece .50
					1 1/2 Offset tail piece .50
					20.60
					* # 1.34 Applied to W.N.C. # 343

DATE \_\_\_\_\_

TOWN OF LEXINGTON — BOARD OF PUBLIC WORKS

**WATER DIVISION**

Sketch of Service Here

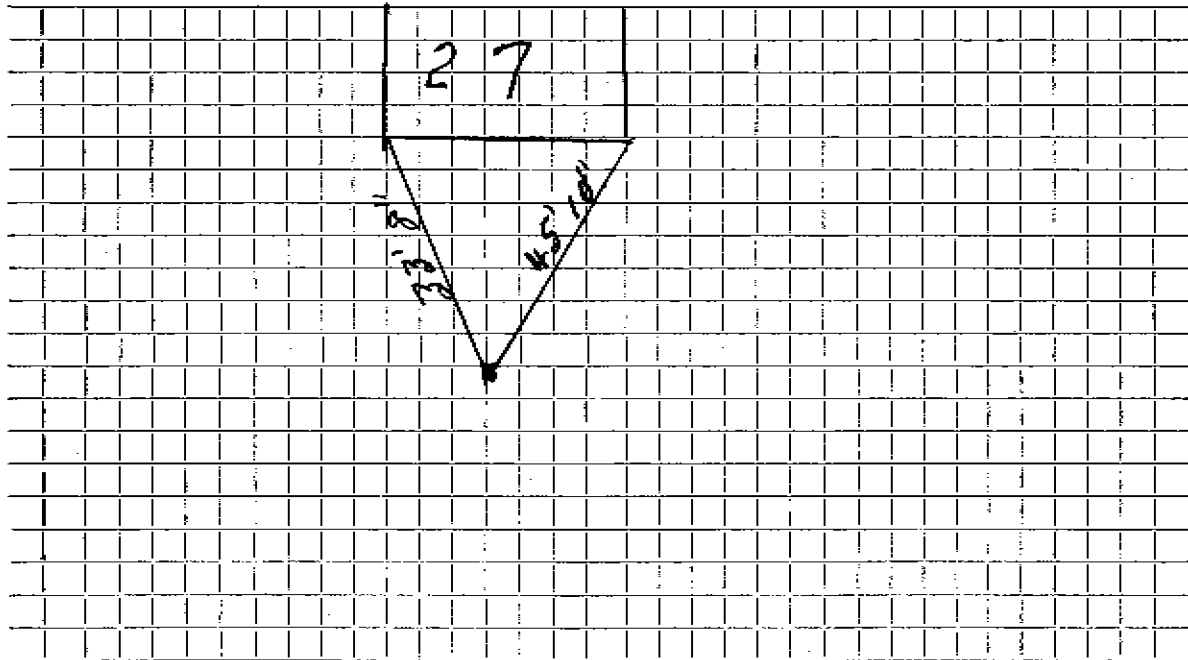

Connection made in ..... Street. Work completed .....

Remarks: .....  
.....  
.....