

## WATER SERVICE RECORD

Name Bernard Maloney

Service No. 238

Address 31 Hayward Avenue

# 2242

Location

Repair—Renewal—New Service

Comm. 2/16/59


Date	Material	Amount	Total	Date	Amount
11/18/58	Labor	26 99		11/6/58	Deposit \$ 100 00
	10% overhead	2 70	29 69	2/16/59	Refund 35 48
	50' - 3/4" Copper tubing @ .37		18 50		# 64 52
	1 - 3/4" Cx 1/2 I.W.H. Stop & Waste		5 84		NON CHARGE
	1 1/2 hrs. Town Shovel @ 6.50		9 75		Labor 9 17
	1 hr. Trucking		75		17' - 3/4" Copper tubing @ .37 6 29
			64 52		1 - 3/4" C. Corp Cock 4 64
					1 - 3/4" C. Curb Cock 6 03
					1 Box & Rod 5 00
					1/2 hr. Town Shovel @ 6.50 3 25
					34 38

DATE \_\_\_\_\_

TOWN OF LEXINGTON — BOARD OF PUBLIC WORKS

WATER DIVISION

Sketch of Service Here

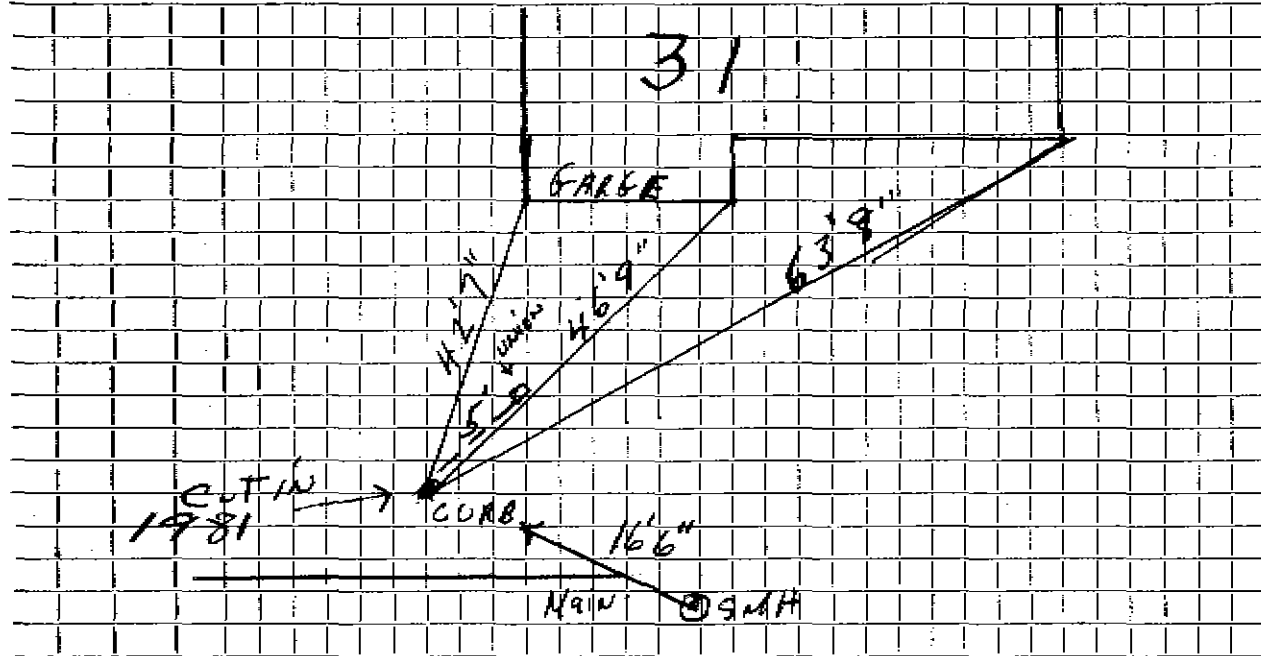

Connection made in ..... Street. Work completed .....

Remarks: *There is another curb 17' in from main could not locate, curb broke water*