

WATER SERVICE RECORD

Name Bernard Maloney

Service No. 52

Address 33 Hayward Avenue

Location

~~Repair/Repair~~ New Service

Cam 5-459


Date	Material	Amount	Total	Date	Amount
4-15-59	Labor	6.96		4-15-59	108.00
	10% Labor	.70	7.66	5-4-59	<u>76.45</u>
24'	3/4" Copper tubing @.3666	8.80			29.55
1	3/4" C x 1/2 I.W.H. Stop & Waste	5.84			NON CHARGE
1	hr. Trucking @.75	.75			Labor
1	hr. Town Shovel @6.50	6.50			4.64
			29.55	16'	3/4" Copper tubing @.3666
				1	3/4" C Corp Cock
				1	3/4" C Curb Cock
				1	Box & Rod
				1	1/2 Straight tailpiece
				1	1/2 Offset tailpiece
				1	hr. Town Shovel @6.50
					<u>6.50</u>
					33.68

DATE _____

TOWN OF LEXINGTON — BOARD OF PUBLIC WORKS

WATER DIVISION

Sketch of Service Here

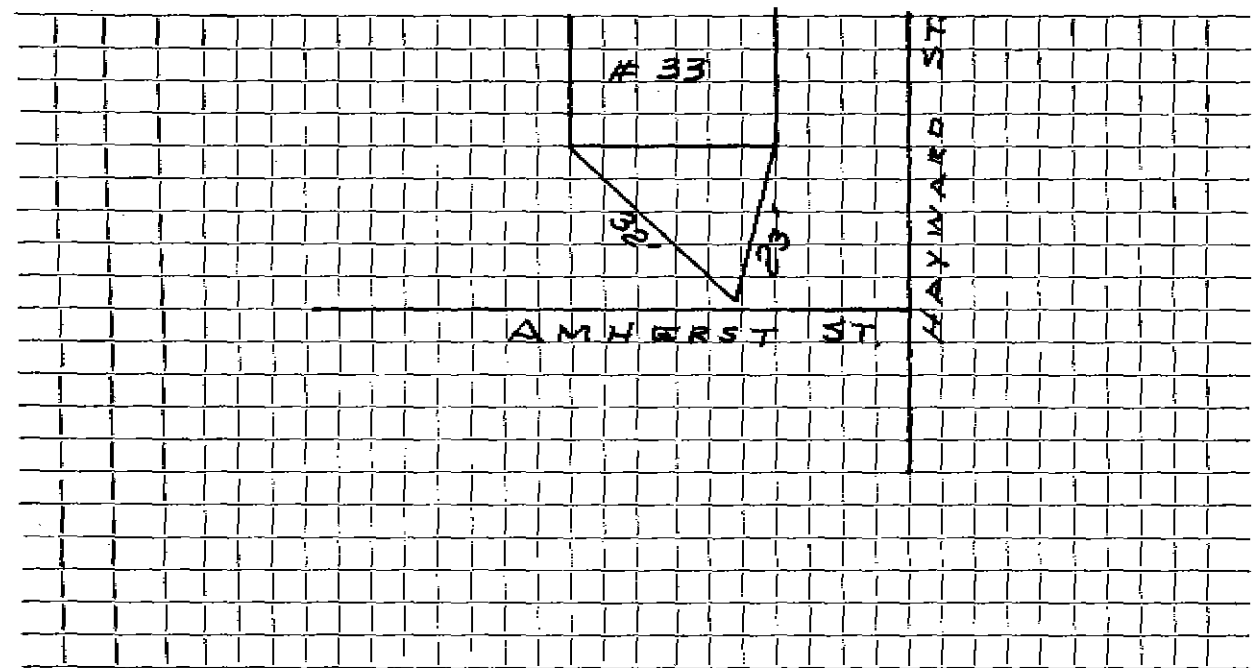

Connection made in Street. Work completed

Remarks:
.....
.....