

WATER SERVICE RECORD

Name Cruwys & Bennett Const. Co.Service No. 284Address 35 Hayward Avenue

Location _____

~~Repair~~—~~Renewal~~—New ServiceCom 3-16-57


Date	Material	Amount	Total	Date	Amount
12/29/58	Labor	37 24		12/16-58 <i>Deposit</i>	100 00
	10% overhead	3 72	40 96	3/16-59 <i>Retained</i>	27 09
	28' - 3/4" Copper tubing @ .37		10 36		72 91
	1 - 3/4" Cx 1/2 I.W.H. Stop & Waste		5 84		
	1 1/2 hrs. Town Shovel @ 6.50		9 75		NON CHARGE
	1 1/2 hrs. Compressor @ 3.00		4 50	12/29/58	Labor
	2 hrs. Trucking @ .75		1 50	24' - 3/4" Copper tubing @ .37	8 88
			72 91	1 - 3/4" C. Corp Cock	4 64
				1 - 3/4" C. Curb Cock	6 03
				1 Box & Rd	5 00
				1 - 1/2 Straight tailpiece	50
				1 - 1/2 Offset tailpiece	50
				1 1/2 hrs. Town Shovel @ 6.50	9 75
				1 1/2 hrs. Compressor @ 3.00	4 50
				1 hr. Trucking	75
					72 55

DATE _____

TOWN OF LEXINGTON — BOARD OF PUBLIC WORKS

WATER DIVISION

Sketch of Service Here

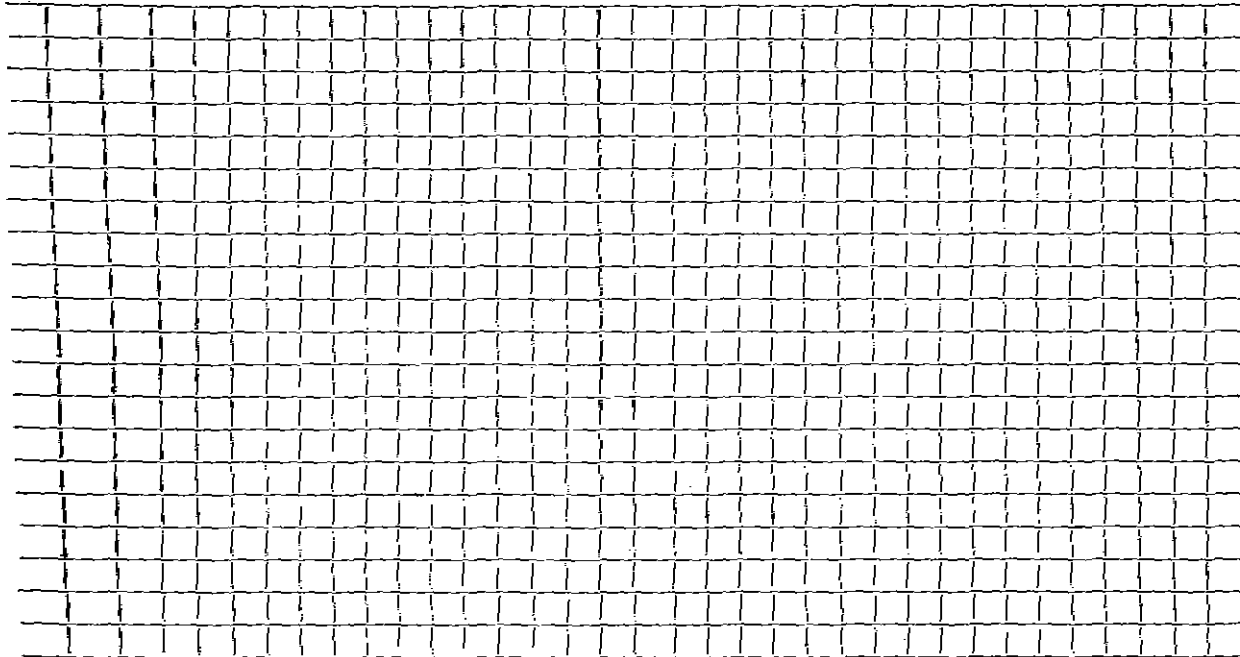

Connection made in Street. Work completed

Remarks:

.....

.....