

WATER SERVICE RECORD

Name Dudley A. Davies

Service No. 190

Address 4 Hayward Av.

Location

~~Repair~~ New Service

Sum - F-1053


Date	Material	Amount	Total	Date	Amount
7/9/53	Labor	1 90		7-10-53	Deposited
	10% overhead	19	2 09	8-24-53	Paid
	25' - 3/4" copper tubing@.3629		9 07		<u>NON CHARGE</u>
	1 -3/4"C x 1/2 I.W.H. stop& waste		4 00	7/9/53	Labor
	1 hr. trucking		75		10' - 3/4" copper tubing@.3629
			15 91		1 -3/4" C. corp-cock
	TRENCH DUG BY OWNER:				1 -3/4"C x 3/4"C. curb-cock
					1 box and rod
					1 -1/2 straight tail piece
					1 -1/2 offset tail piece
					1 hr. trucking
					<u>75</u>
					20 18
					<i>611.53 F-11-53</i>

DATE _____

TOWN OF LEXINGTON - BOARD OF PUBLIC WORKS

WATER DIVISION

Sketch of Service Here

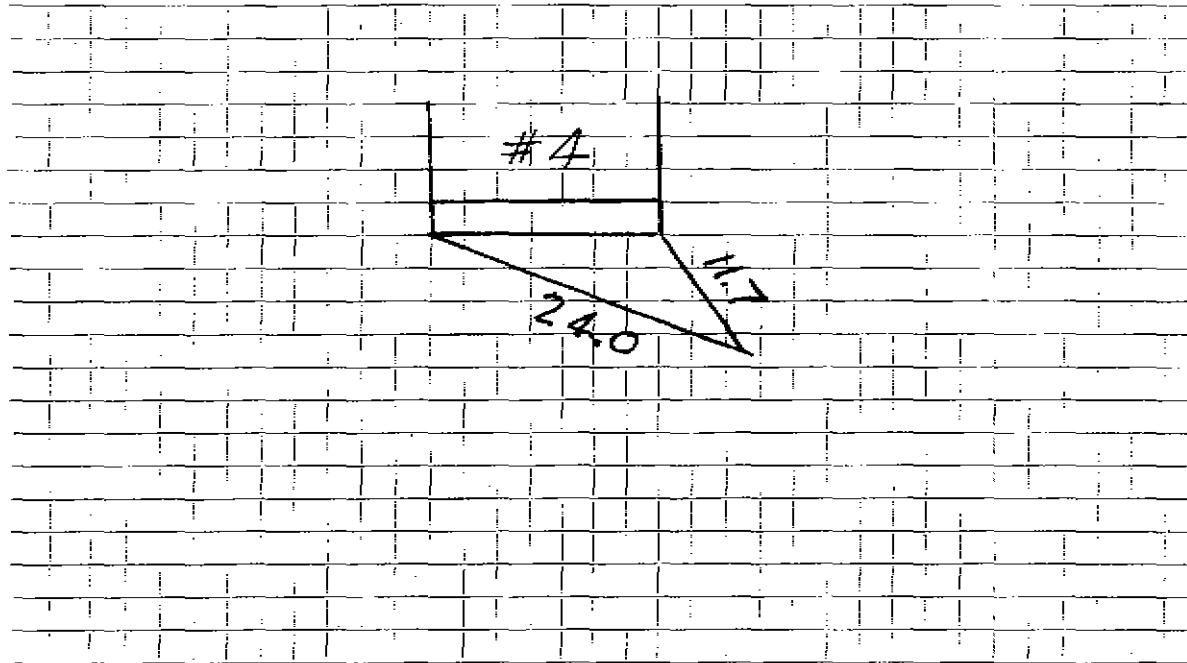

Connection made in Street: Work completed

Remarks:

.....

.....