




DATE \_\_\_\_\_

TOWN OF LEXINGTON — BOARD OF PUBLIC WORKS

WATER DIVISION

Sketch of Service Here  
LOT 34 HAZEL RD

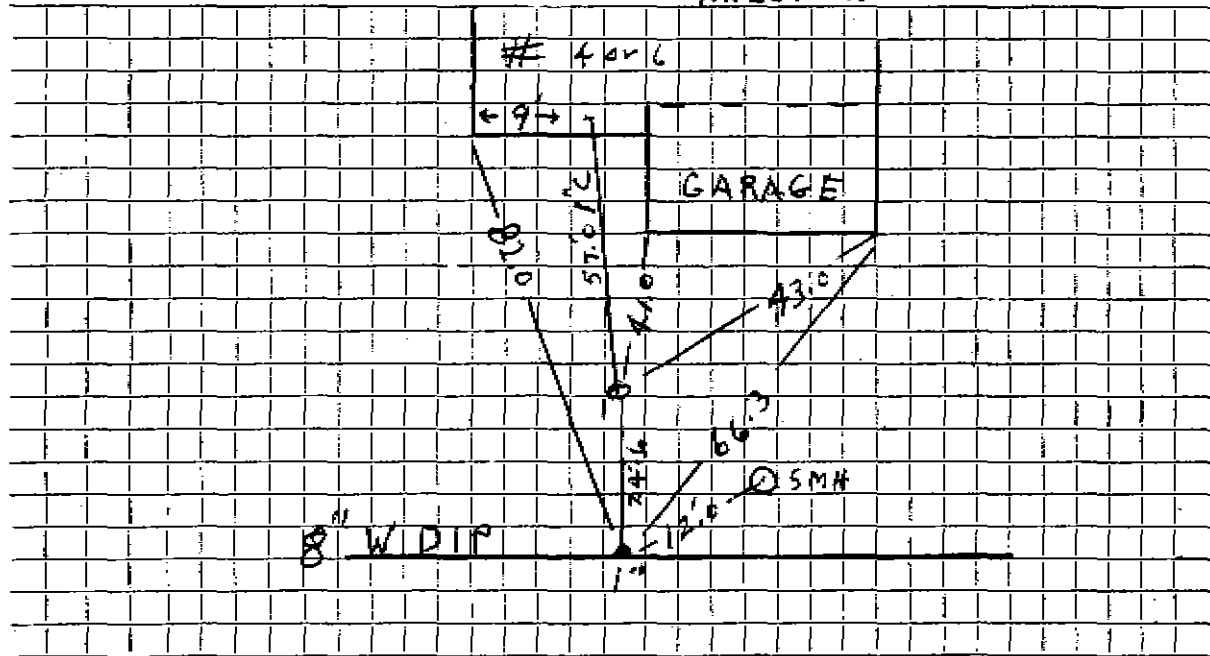

Connection made in ..... Street. Work completed 1/25/04 .....

Remarks: .....  
.....