




DATE 10-11-01

TOWN OF LEXINGTON — BOARD OF PUBLIC WORKS  
WATER DIVISION

Sketch of Service Here

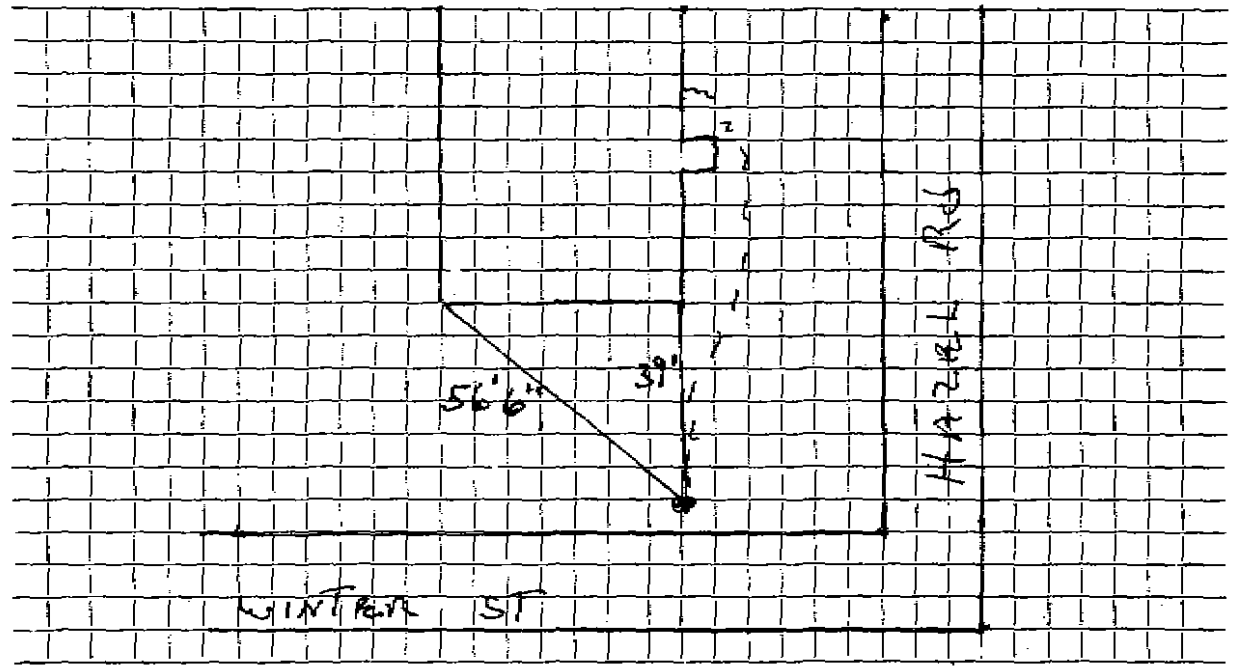

Connection made in .. WINTER .. Street. Work completed ..  
Remarks: Installed .. BY .. ERNIE RODGERS ..  
.. CURB 6" .. FROM .. EDGE .. OF .. RD. ..