

Name Charles Rolando

Service No. 141

Address 15 Henderson Road

Lexington

Location 15 Henderson Road

Kind of Pipe

Size

Size of Main

~~Repair~~ ~~Renewal~~ - New Service

Com. 9-5-50

Location

Date	Material	Amount	Total	Date	Amount
July 11 '50	Labor	2 45		June 23 '50	50 00
	10% Overhead	25	2 70	<i>Deposited</i>	
	31' - 3/4" Copper Tubing @ 23¢	7 13			
	1 - 3/4" C x 1/2" I.W.E. S&W	3 29			
	1 - 3/4" C x 3/4" C Union (3 pts)	1 39		July 11 '50	No Charge
	3 hrs. Littlefield Shovel	21 00			Labor 2 45
	1 hr. Trucking	75			12' - 3/4" Copper Tubing @ 23¢ 2 76
	Patching 6 x 3	6 00			1 - 3/4" G. Corp-cock 3 15
			42 26		1 - 3/4" G x 3/4" C Curb-cock 3 85
					1 Box & Rod 3 35
					1 - 1/2" Offset Tail Piece 38
					1 - 1/2" Straight Tail Piece 38
					1 hr. Littlefield Shovel 7 00
					1 hr. Trucking 75
	Labor				24 07

DATE _____

TOWN OF LEXINGTON—BOARD OF PUBLIC WORKS

WATER DIVISION

The undersigned applies for a supply of water at No. _____ St. and hereby agrees to comply with the rules and regulations as now, or at any future time, established by the Board of Selectmen.

Am't. of Estimate \$ _____


Owner _____

Am't. Paid \$ _____

Address _____

Builder _____

Sketch of Service Here

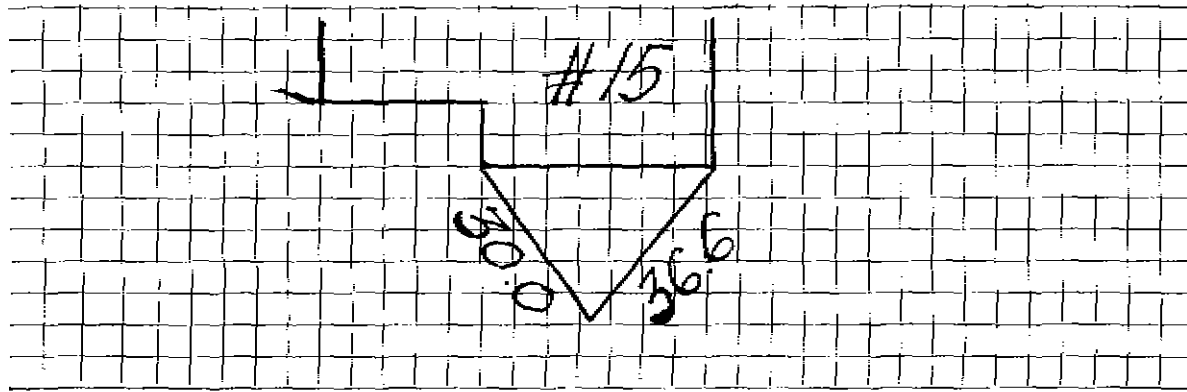

Connection made in _____ Street.

Work completed _____ 19

Remarks: