

WATER SERVICE RECORD

3235

Name Emile Saulnier

Service No. 119

Address 15 Henderson Rd.

Location Lexington

Repair ~~Renewal~~ - New Service

Am. 7-13-53


Date	Material	Amount	Total	Date	Amount
6/15/53	Labor	4 87		6-1-53	Deposited 40 00
	10% overhead	49	5 36	7-13-53	Refunded 09
	40' 3/4" Copper Tubing @.37		14 80		NON CHARGE 39 91
	1-3/4" C x 1/2" I.W.H. STOP & WASTE		4 00	6/15/53	Labor 4 38
	2 Hr. Littlefield Shovel @7.50		15 00	24'-3/4" Copper Tubing @.37	8 58
	1 Hr. Trucking		75	1-3/4" C. Corp-cock	4 33
			59 91	1-3/4" C x 3/4" C. Curb-cock	4 67
				2-Box & Rod	3 90
				1-1/2" offset tail piece	50
				1-1/2" straight tail piece	50
				2 Hr. Littlefield Shovel @7.50	15 00
				1 Hr. Trucking	75
					43 41

DATE _____

TOWN OF LEXINGTON - BOARD OF PUBLIC WORKS

WATER DIVISION

Sketch of Service Here

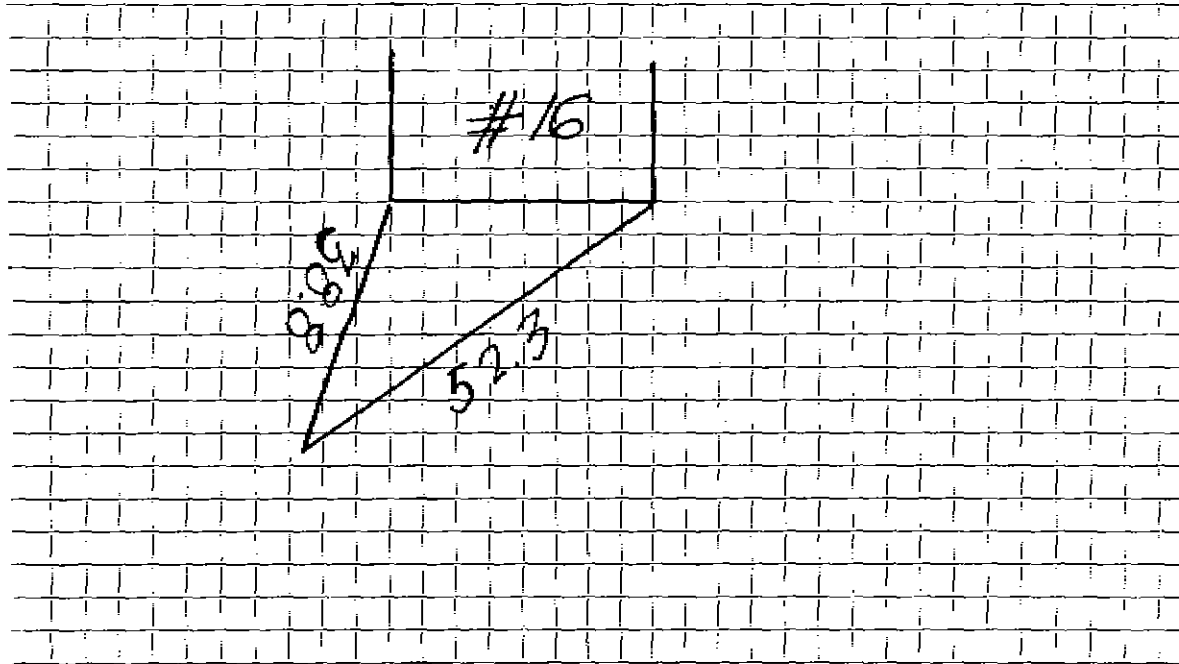

Connection made in Street. Work completed

Remarks:

.....

.....